

OREGON CORNER RESTORATION FORM

COUNTY: Umatilla DATE: 08/13/13

CORNER DESIGNATION: 3N32, C01, The West One-Quarter Corner of Section 6.

PREVIOUS RENEWALS/SURVEYS ETC.: Corner originally established by D. S. Payne, under Contract 100, dated August, 1, 1861. Notes state: Set charred stake with mound, trench and pits as per insts. For 1/4 sec. corner.

MONUMENT AND ACCESSORIES FOUND: None.

MONUMENT MARKING DETAIL:

T3N
R31E R32E
1/4
S1 | S6
2013
PLS 54657

MONUMENT SET: Held a point 1 foot West of old locust post with field berms North, East and West as best remaining evidence of the original corner position and set a 2 3/8" brass cap on a 1 1/4" x 30" galvanized iron pipe with top flush with ground, marked as shown in "Monument Marking Detail", from which:

- A silver deep-1 magnet, buried 20" in ground, bears North 57° East, 27.2 feet.
 - A pink deep-1 magnet, buried 20" in ground, bears South 47° East, 26.7 feet.
 - A blue deep-1 magnet, buried 20" in the ground, bears South 44° West, 32.0 feet.
 - An orange deep-1 magnet, buried 20" in the ground, bears North 63° West, 29.1 feet.
- Attached bearing object tags with magnets.

LOCATION AND COMMENTS:


OREGON STATE PLANE COORDINATE, North Zone, NAD 83(91), International Feet:
N= 770621.42'
E= 8617894.39'

FIRM: Wells Surveying
P.O. Box 1696
Pendleton, OR 97801

COMPASS DECLINATION: 18° East

Surveyor's Seal

Witnesses: Jason Wells, PLS
Dean Roy
3N32C01

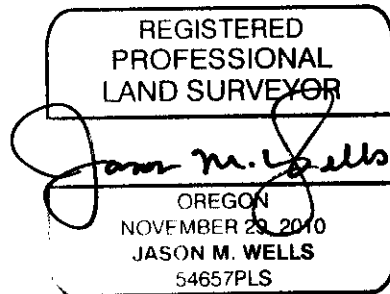

RENEWS: 6-30-14