

**OREGON CORNER RESTORATION FORM**

COUNTY: Umatilla DATE: 09/23/13

CORNER DESIGNATION: 3N32, J01, The Northwest Corner of Section 18.

PREVIOUS RENEWALS/SURVEYS ETC.: Corner originally established by D. S. Payne, under Contract 100, dated August, 1, 1861. Notes state: Set charred stake with mound trench and pits as per instrs. for corner to sections 12 & 13 R31 and 7 & 18, R32 Town 3 North. John Kimbrell, in his survey recorded in Record of Private Survey Book 1, Page 424, in 1900, reports setting a stone for the corner point. Frank Hayes, in undated Survey No. Q-521-C, states he set a 6 by 8 by 12" marked stone, 18" deep for the corner. Hayes measurements along the North line of the NW1/4 of Section 18 appear to be in error by about 100 feet.

MONUMENT AND ACCESSORIES FOUND: None.

MONUMENT MARKING DETAIL:

T3N  
R31E R32E  
12 | 7  
13 | 18  
2013  
PLS 54657

MONUMENT SET: Held the intersection of the proportional latitude between the West 1/4 corner of Section 6 and the Southwest corner of Section 18 with a North-South field line as best remaining evidence of the original corner point. At the reestablished corner point, set a 2 3/8" brass cap on a 1 1/4" x 30" galvanized iron pipe with top 20" below ground, marked as shown in "Monument Marking Detail", from which:

- A silver deep-1 magnet, buried 20" below ground, bears North 50° East, 29.4 feet.
  - A pink deep-1 magnet, buried 20" below ground, bears South 34° East, 33.9 feet.
  - A blue deep-1 magnet, buried 20" below ground, bears South 46° West, 29.5 feet.
  - An orange deep-1 magnet, buried 20" below ground, bears North 46 1/2° West, 36.0 feet.
- Buried bearing object tags with magnets.

LOCATION AND COMMENTS: Corner approximately 200' +/- North of Despain Gulch Road in North-South field line.


OREGON STATE PLANE COORDINATE, North Zone, NAD 83(91), International Feet:  
N= 762659.15'  
E= 8617993.65'

FIRM: Wells Surveying  
P.O. Box 1696  
Pendleton, OR 97801

COMPASS DECLINATION: 18° East  
Witnesses: Jason Wells, PLS  
Dean Roy

Surveyor's Seal

\3N32J01

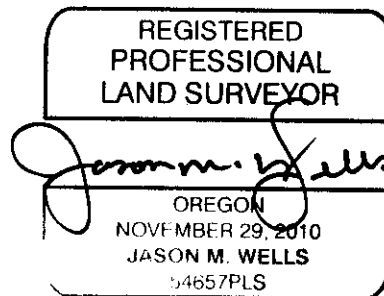

RENEWS: 6-30-14