

OREGON CORNER RESTORATION FORM

COUNTY: Umatilla DATE: 08/15/13

CORNER DESIGNATION: 3N32, J17, The Northwest Corner of Section 14.

PREVIOUS RENEWALS/SURVEYS ETC.: Corner originally established by David Chaplin, under Contract 107, dated September 1864, notes state: Set post for corner to secs 10, 11, 14 & 15 in mound of Earth with charred stake pits & c as per instructions.

MONUMENT AND ACCESSORIES FOUND: None.

MONUMENT MARKING DETAIL:

T3N R32E
S10 | S11
S15 | S14
2013
PLS 54657

MONUMENT SET: Held a point in a North-South field berm at an old steel fence marking post as best available evidence of the original corner position. At the reestablished corner position, set a 2 3/8" brass cap on a 1 1/4" x 30" galvanized iron pipe with top 20" below ground level marked as shown in "Monument Marking Detail", from which:

- A silver deep-1 magnet, 20" below ground level, bears North 38 1/2° East, 27.9 feet.
 - A pink deep-1 magnet, 20" below ground level, bears South 41° East, 28.2 feet.
 - A blue deep-1 magnet, 20" below ground level, bears South 41° West, 35.2 feet.
 - An orange deep-1 magnet, 20" below ground level, bears North 52 1/2° West, 37.5 feet.
- Buried bearing object rags with magnets, attached witness post sign to steel fence post, 1.0 feet East of monument.

LOCATION AND COMMENTS: Located in a North-South field berm at an old steel fence marking post.

OREGON STATE PLANE COORDINATE, North Zone, NAD 83(91), International Feet:

N= 763023.00'
E= 8639401.57'


FIRM: Wells Surveying
P.O. Box 1696
Pendleton, OR 97801

COMPASS DECLINATION: 18° East

Surveyor's Seal

Witnesses: Jason Wells, PLS
Dean Roy

\3N32J17

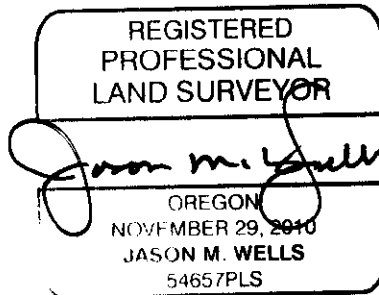

RENEWS: 6-30-14