

OREGON CORNER RESTORATION FORM

COUNTY: Umatilla DATE: 04/17/13

CORNER DESIGNATION: 3N32, P9, The West One-Quarter Corner of Section 21.

PREVIOUS RENEWALS/SURVEYS ETC.: Corner originally established by David Chaplin, under GLO Contract dated September 1864, notes state: Set post for 1/4 Sec. corner in mound of earth with charred stake & pits as per instructions. A hub and tack was found and accepted as the corner on Umatilla County Survey 12-126-B.

MONUMENT AND ACCESSORIES FOUND: Found hub and tack at the South side of railroad tie field marker with old field berms North and West and South and the North edge of a field road East.

MONUMENT MARKING DETAIL:

T3N R32E
1/4
S20|S21
2013
PLS 54657

MONUMENT SET: I accept the position of the hub and tack as the corner point and set a 2 3/8" brass cap on a 1 1/4" x 30" galvanized iron pipe, with top flush with the ground, stamped as stated in "Monument Marking Detail", from which:

A 5/8" x 24" iron rod with a 1 1/4" purple plastic cap marked "Wells Surveying, PLS 54657", set 6" below ground in bank on North side of field road between road and farmed field, bears South 89° East, 25.3 feet.

A 5/8" x 24" iron rod with a 1 1/4" purple plastic cap marked "Wells Surveying, PLS 54657", set 6" below ground in bank on North side of field road between road and farmed field, bears South 87° East, 51.1 feet.

A blue deep-1 magnet, 18" below ground, bears South 08° West, 41.5 feet.

A 5/8" x 24" iron rod with a 1 1/4" purple plastic cap marked "Wells Surveying, PLS 54657", set 6" below ground in bank on North side of field road between road and farmed field, bears South 88° West, 18.1 feet.

Wired bearing object signs to rebar and buried bearing object signs with magnets. Attached witness post sign to railroad tie post 8" North of monument.

LOCATION AND COMMENTS:

Monument set 8 inches South of centerline of rail road tie field marker post on North side of farm field road.

OREGON STATE PLANE COORDINATE, North Zone, NAD 83(91), International Feet:

N= 754961.76'
E= 8628989.11'


FIRM: Wells Surveying
P.O. Box 1696
Pendleton, OR 97801

COMPASS DECLINATION: 18° East

Surveyor's Seal

Witnesses: Jason Wells, PLS
Dean Roy

/3N32P09

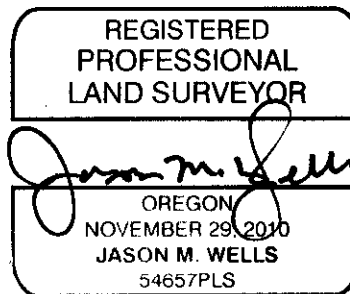

RENEWS: 6-30-14