

OREGON CORNER RESTORATION FORM

COUNTY: Umatilla DATE: 04/17/13

CORNER DESIGNATION: 3N32, R11, The South One-Quarter Corner of Section 21.

PREVIOUS RENEWALS/SURVEYS ETC.: Corner originally established by David Chaplin, under GLO Contract dated September 1864, notes state: Set post for 1/4 Sec. corner in mound of earth with charred stake & pits as per instructions.

MONUMENT AND ACCESSORIES FOUND: None.

MONUMENT MARKING DETAIL:

T3N R32E
1 S21
4 S28
2013
PLS 54657

MONUMENT SET: Reestablished corner at the held intersection of field berms North-South-East & West as the best remaining evidence of the original corner location and set a 2 3/8" brass cap on a 1 1/4" x 30" galvanized iron pipe, with top flush with the ground, stamped as stated in "Monument Marking Detail", from which:

- A silver deep-1 magnet, 20" below ground surface bears North 49° East, 17.2 feet.
 - A purple deep-1 magnet, 20" below ground surface bears South 48° East, 26.7 feet.
 - A blue deep-1 magnet, 20" below ground, bears South 41° West, 26.3 feet.
 - An orange deep-1 magnet, 20" below ground, bears North 51° West, 24.7 feet.
- Buried bearing object signs with magnets. Attached witness post sign to railroad tie, 1.0 feet North of monument.

LOCATION AND COMMENTS: Located at the intersection of field berms 1 foot south of a railroad tie marker post.


OREGON STATE PLANE COORDINATE, North Zone, NAD 83(91), International Feet:
N= 752371.57'
E= 8631692.36'

FIRM: Wells Surveying
P.O. Box 1696
Pendleton, OR 97801

COMPASS DECLINATION: 18° East Surveyor's Seal

Witnesses: Jason Wells, PLS
Dean Roy

/3N32R11

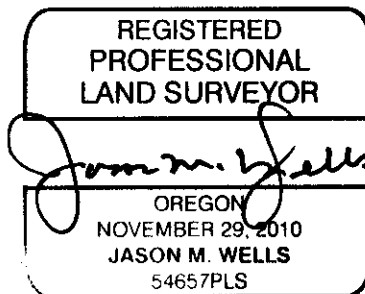

RENEWS: 6-30-14