

OREGON CORNER RESTORATION FORM

Section 3,4 Township 3N
County Umatilla Date: 03/25/11

Range 33E

Corner Designation: 3N33A17

Section corner common to sections 34,35, T4NR33E, 3,4, T3NR33E.

- Condition Report Only
- Not Found
- Remonumented
- Unrecorded
- Surveyed In
- Referenced Out


Previous Renewals / Surveys, etc.

Originally Surveyed by Thompson in 1864. He set a post in a mound of earth. Krumbein set a 2 1/2" brass cap in 1988, in survey M-121-C.


Monuments and Accessories Found: (Condition and Source)

A 2 1/2" B.C., 8" below surface, stamped with the year 1988 and Um. Co. Surveyor. No record of a monument with this date.

Diagram

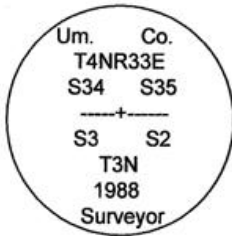

Sketch

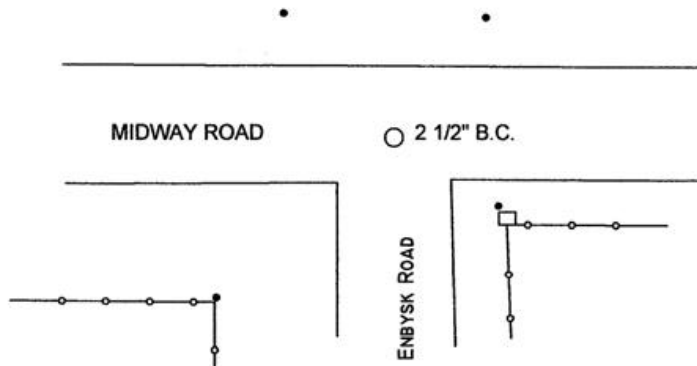

NAD 83/91
OREGON STATE PLANE NORTH
INTERNATIONAL FEET

N774311.96
E8670651.23

Monument (s) Set (Procedures and Description)

None.

References Set: "Deep One" magnets by Berntsen.

An Orange magnet, 15" deep, lies N 45°10' W, 39.74'.

A Silver magnet, 16" deep, lies N 43°40' E, 37.66'.

A 5/8" x 30" iron rebar w/rpc #43406, lies S 37° E, 28.98', at a RR Tie Fence post.

A 5/8" x 30" iron rebar w/rpc #43406, lies S 40°30' W, 75.37', at a Chainlink fence corner.

Surveyors Seal

Location and Comments

The corner is in the intersection of Enbysk Road and Midway Road.

Compass Declination

17° E

REGISTERED
PROFESSIONAL
LAND SURVEYOR

Robert D. English
OREGON
JANUARY 11, 2005
ROBERT DOUGLAS ENGLISH
43406LS

RECEIVED BY:

Date: _____
Rec'd By: _____
No. _____

Firm / Agency

Survey One, LLC.
P.O. Box 382
Pendleton, OR 97801
(541) 276-2055

RENEWAL DATE: 12/31/11