

OREGON CORNER RESTORATION FORM

Section: 3, 4
County: Umatilla

Township: 3N
Date: 8/17/2011

Range: 33E

Corner Designation: 3N33C13

Quarter corner common to Sections 3, 4, T3NR33E.

<input checked="" type="checkbox"/>	Condition Report Only
<input type="checkbox"/>	Not Found
<input type="checkbox"/>	Remonumented
<input type="checkbox"/>	Unrecorded
<input type="checkbox"/>	Surveyed In
<input checked="" type="checkbox"/>	Referenced Out


Previous Renewals / Surveys, etc.

Originally surveyed by Chaplin in 1864. He set a post in a mound of earth.
In 2005 Flowers set a 1 1/2" x 30" galvanized iron pipe with a 2 1/2" brass cap.


Monuments and Accessories Found: (Condition and Source):

A 2 1/2" brass cap, stamped as shown below, 15" below the surface.

Diagram

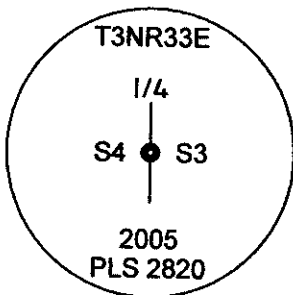

Sketch

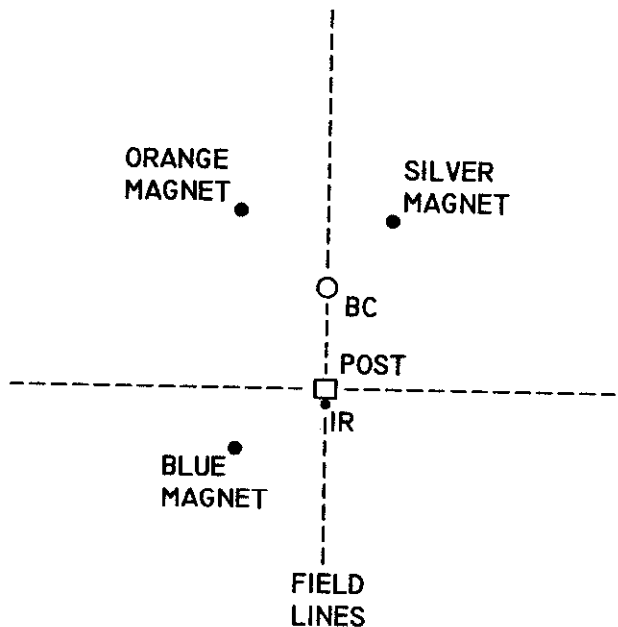

NAD 83/91
OREGON STATE PLANE NORTH
INTERNATIONAL FEET

N771509.97
E8665541.80

Monument(s) Set (Procedures and Description):

None.

References Set:

"Deep One" magnets by Berntsen.
An orange magnet lies N 48° 30' W, 29.57', 1.5' deep.
A silver magnet lies N 44° E, 24.07', 1.6' deep.
A 5/8" x 30" iron rebar w/RPC #43406 lies S 2° 20' W, 29.02', at an old juniper post.
A blue magnet lies S 29° 50' W, 48.29', 1.4' deep.

Location and Comments:

The corner is located 1/2 mile South of the intersection of Midway Rd. and Molstrom Rd.

Compass Declination
17° E

Surveyors Seal

REGISTERED
PROFESSIONAL
LAND SURVEYOR

Robert D. English
OREGON
JANUARY 11, 2005
ROBERT DOUGLAS ENGLISH
43406LS

RENEWAL DATE: 12/31/13

RECEIVED BY:

Date: 7/10/2012
Rec'd By: S. Pres
No. 12-094-C

Firm / Agency

Survey One, LLC.
P.O. Box 382
Pendleton, OR 97801
(541) 276-2055