

**OREGON CORNER RESTORATION FORM**

Section: 5, 6 Township: 3N Range: 33E  
County: Umatilla Date: 9/30/2011

Corner Designation: 3N33C05

Quarter corner common to Sections 5, 6, T3NR33E.

_____	Condition Report Only
X	Not Found
X	Remonumented
_____	Unrecorded
X	Surveyed In
X	Referenced Out


**Previous Renewals / Surveys, etc.**

Originally surveyed by Chaplin in 1864. He set a post in a mound of earth.


**Monuments and Accessories Found: (Condition and Source):**

None.

Diagram

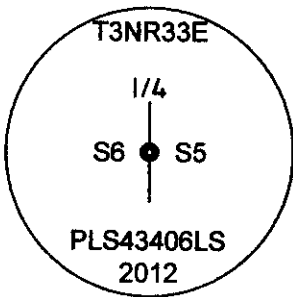

Sketch

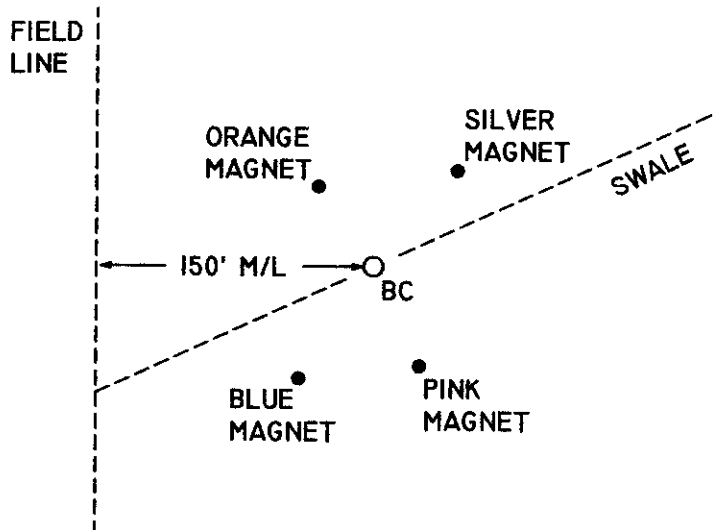

NAD 83/91  
OREGON STATE PLANE NORTH  
INTERNATIONAL FEET

N771323.23  
E8654931.55

**Monument(s) Set (Procedures and Description):**

A 1 1/8" x 30" galvanized iron pipe with a 2 1/2" brass cap, stamped as shown above, 1.5' below the surface.

**References Set:**

"Deep One" magnets by Berntsen.  
An orange magnet lies N 79° W, 11.88', 1.6' deep.  
A silver magnet lies N 79° 50' E, 14.17', 1.6' deep.  
A pink magnet lies S 19° 40' E, 32.81', 1.6' deep.  
A blue magnet lies S 22° 05' W, 33.78', 1.6' deep.

**Location and Comments:**

The corner is located 1/2 mile South and 1/2 mile West of the intersection of Midway Rd. and Myrick Rd.

**Compass Declination**

17° E

**Surveyors Seal**

REGISTERED  
PROFESSIONAL  
LAND SURVEYOR

*Robert D. English*  
OREGON  
JANUARY 11, 2005  
ROBERT DOUGLAS ENGLISH  
43406LS

RENEWAL DATE: 12/31/13

**RECEIVED BY:**

Date: 7/10/2012  
Rec'd By: S. Olsen  
No. 12-094-C

**Firm / Agency**

Survey One, LLC.  
P.O. Box 382  
Pendleton, OR 97801  
(541) 276-2055