

**OREGON CORNER RESTORATION FORM**

Section: 4, 9 Township: 3N Range: 33E  
County: Umatilla Date: 3/3/2011

Corner Designation: 3N33E11 (Amended 3/6/2012)

Quarter corner common to Sections 4, 9, T3NR33E.

<u>    </u>	X	Condition Report Only
<u>    </u>		Not Found
<u>    </u>		Remonumented
<u>    </u>		Unrecorded
<u>    </u>		Surveyed In
<u>    </u>	X	Referenced Out


**Previous Renewals / Surveys, etc.**

Originally surveyed by Chaplin in 1864. He set a post in a mound of earth.  
In 1985 Krumbein set a brass cap in LCR E11-86-72R.


**Monuments and Accessories Found: (Condition and Source):**

A 2 1/2" brass cap 23" below the surface with a bent steel fence post guard within 1' South of the monument.

Diagram

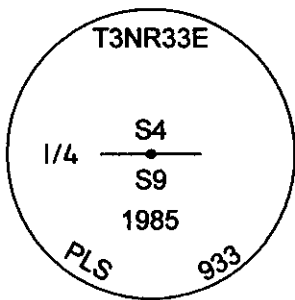

Sketch

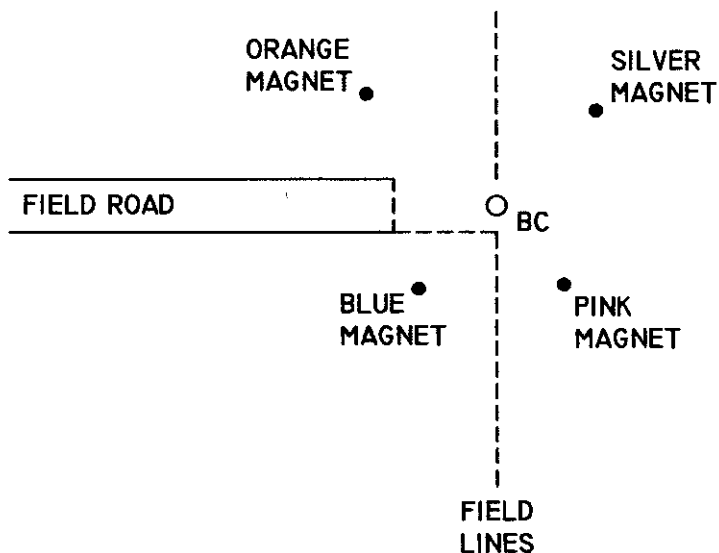

NAD 83/91  
OREGON STATE PLANE NORTH  
INTERNATIONAL FEET

N768805.97  
E8663026.79

**Monument(s) Set (Procedures and Description):**

None.

**References Set:**

"Deep One" magnets by Berntsen.  
An orange magnet lies N 44° 30' W, 33.57', 1.3' deep.  
A silver magnet lies N 30° E, 32.36', 1.4' deep.  
A pink magnet lies S 39° E, 25.18', 1.4' deep.  
A blue magnet lies S 36° 40' W, 31.81', 1.4' deep.

**Location and Comments:**

The corner is 1 mile East of the intersection of Anderson Rd. and Myrick Rd., on a field road.

**Compass Declination**

17° E

**Surveyors Seal**

REGISTERED  
PROFESSIONAL  
LAND SURVEYOR

*Robert D. English*  
OREGON  
JANUARY 11, 2005  
ROBERT DOUGLAS ENGLISH  
43406LS

RENEWAL DATE: 12/31/13

**RECEIVED BY:**

**Firm / Agency**

Date: 7/10/2012  
Rec'd By: [Signature]  
No. 13-094-C

Survey One, LLC.  
P.O. Box 382  
Pendleton, OR 97801  
(541) 276-2055