

**OREGON CORNER RESTORATION FORM**

Section: 5, 8      Township: 3N      Range: 33E  
County: Umatilla      Date: 2/18/2011

Corner Designation: 3N33E07 (Amended 3/27/2012)

Quarter corner common to Sections 5, 8, T3NR33E.

- Condition Report Only
- Not Found
- Remonumented
- Unrecorded
- Surveyed In
- Referenced Out


**Previous Renewals / Surveys, etc.**

Originally surveyed by Chaplin in 1864. He set post in a mound of earth.  
In 1981 Krumbein accepted the intersection of Anderson Rd. and Myrick Rd.  
as the corner location in Survey S-153-B.  
In 1986 Krumbein set a 2 1/2" brass cap.


**Monuments and Accessories Found: (Condition and Source):**

A 2 1/2" brass cap, stamped as shown below, 7" below the surface.

**Diagram**

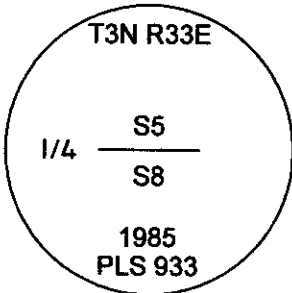

**Sketch**

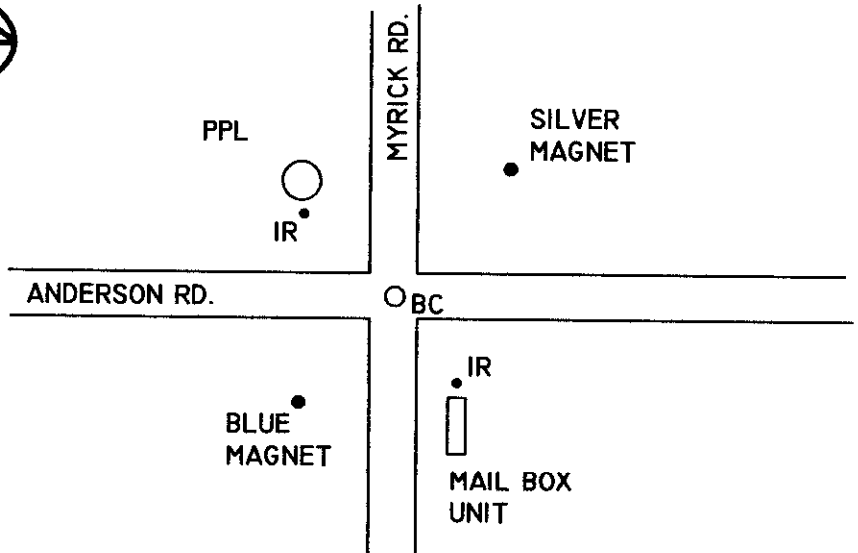

NAD 83/91  
OREGON STATE PLANE NORTH  
INTERNATIONAL FEET

N768733.47  
E8657712.38

**Monument(s) Set (Procedures and Description):**

None.

**References Set:**

"Deep One" magnets by Berntsen.  
A 5/8" x 30" iron rebar w/RPC #43406 lies N 47° 20' W, 32.71', at a power pole.  
A silver magnet lies N 42° 20' E, 44.95', 15" below the surface.  
A 5/8" x 30" iron rebar w/RPC #43406 lies S 35° 50' E, 28.64', at a mail box unit.  
A blue magnet lies S 42° 10' W, 36.90', 15" below the surface.

**Location and Comments:**

The corner is located at the intersection of  
Anderson Rd. and Myrick Rd.

**Compass Declination**

17° E

**Surveyors Seal**

REGISTERED  
PROFESSIONAL  
LAND SURVEYOR

*Robert D. English*  
OREGON  
JANUARY 11, 2005  
ROBERT DOUGLAS ENGLISH  
43406LS

RENEWAL DATE: 12/31/13

**RECEIVED BY:**

**Firm / Agency**

Date: 7/10/2012  
Rec'd By: S. Oles  
No. 12-094-C

Survey One, LLC.  
P.O. Box 382  
Pendleton, OR 97801  
(541) 276-2055