

OREGON CORNER RESTORATION FORM

Section: 8, 9 Township: 3N Range: 33E
County: Umatilla Date: 5/18/2011

Corner Designation: 3N33G09

Quarter corner common to Sections 8, 9, T3NR33E.

_____	Condition Report Only
X	Not Found
X	Remonumented
_____	Unrecorded
X	Surveyed In
X	Referenced Out


Previous Renewals / Surveys, etc.

Originally surveyed by Chaplin in 1864. He set a post in a mound of earth.

Monuments and Accessories Found: (Condition and Source):


None.

Diagram

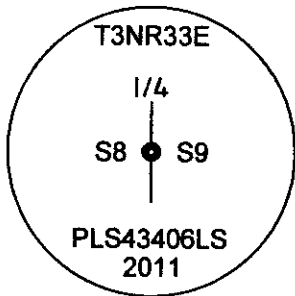

ORANGE
MAGNET

Sketch

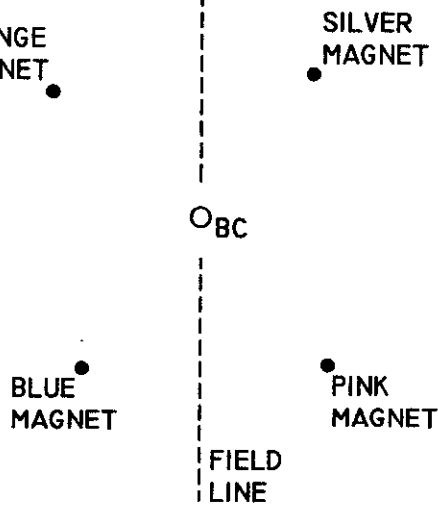

NAD 83/91
OREGON STATE PLANE NORTH
INTERNATIONAL FEET

N766120.13
E8660443.81

Monument(s) Set (Procedures and Description):

A 1 1/8" x 30" galvanized iron pipe with 2 1/2" brass cap, stamped as shown above, 1.3' below the surface. The corner location was reestablished through a combination of holding a very well established field line for Easting and single proportionate method for Northing.

References Set:

"Deep One" magnets by Bermtsen.
An orange magnet lies N 49° 15' W, 19.81', 1.5' deep.
A silver magnet lies N 39° E, 18.97', 1.5' deep.
A pink magnet lies S 39° 45' E, 20.15', 1.2' deep.
A blue magnet lies S 39° W, 20.07', 1.3' deep.

Location and Comments:

The corner is located 1/2 mile North and 1/2 mile East of the intersection of Shafer Rd. and Myrick Rd.

Compass Declination

17° E

Surveyors Seal

REGISTERED
PROFESSIONAL
LAND SURVEYOR

Robert D. English
OREGON
JANUARY II, 2005
ROBERT DOUGLAS ENGLISH
43406LS

RENEWAL DATE: 12/31/13

RECEIVED BY:

Firm / Agency

Date: 7/10/2012
Rec'd By: [Signature]
No. 12-094-C

Survey One, LLC.
P.O. Box 382
Pendleton, OR 97801
(541) 276-2055