

**OREGON CORNER RESTORATION FORM**

Section: 9, 16  
County: Umatilla

Township: 3N  
Date: 5/24/2011

Range: 33E

Corner Designation: 3N33J11

Quarter corner common to Sections 9, 16, T3NR33E.

_____	Condition Report Only
<u>  X  </u>	Not Found
<u>  X  </u>	Remonumented
_____	Unrecorded
<u>  X  </u>	Surveyed In
<u>  X  </u>	Referenced Out


**Previous Renewals / Surveys, etc.**

Originally surveyed by Chaplin in 1864. He set a post in a mound of earth.

**Monuments and Accessories Found: (Condition and Source):**

None.

Diagram

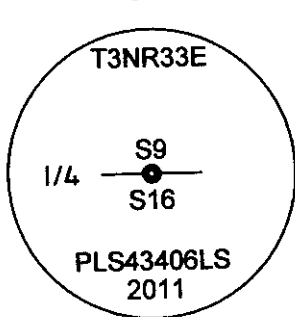

ORANGE  
MAGNET

Sketch

SILVER  
MAGNET

SHAFER RD.

○ BC

NAD 83/91  
OREGON STATE PLANE NORTH  
INTERNATIONAL FEET

N763521.92  
E8663248.56

BLUE  
MAGNET

PINK  
MAGNET

**Monument(s) Set (Procedures and Description):**

A 1 1/8" x 30" galvanized iron pipe with a 2 1/2" brass cap, stamped as shown above, 1.1' below the surface. Corner location reestablished by holding field line to the North, visible for nearly 2 miles, and by holding the centerline of Shafer Road, per Umatilla County Road Notes, as best evidence of the original corner position.

**References Set:**

- "Deep One" magnets by Bermtsen.
- An orange magnet lies N 44° 50' W, 29.43', 1.5' deep.
- A silver magnet lies N 32° 50' E, 27.19', 1.2' deep.
- A pink magnet lies S 41° 45' E, 22.07', 1.5' deep.
- A blue magnet lies S 42° 50' W, 29.15', 1.4' deep.

**Location and Comments:**

The corner is located in Shafer Rd., 1 mile East of the intersection of Shafer Rd. and Myrick Rd.

**Compass Declination**

17° E

**Surveyors Seal**

REGISTERED  
PROFESSIONAL  
LAND SURVEYOR

*Robert D. English*

OREGON  
JANUARY II, 2005  
ROBERT DOUGLAS ENGLISH  
43406LS

RENEWAL DATE: 12/31/13

**RECEIVED BY:**

**Firm / Agency**

Survey One, LLC.  
P.O. Box 382  
Pendleton, OR 97801  
(541) 276-2055

Date: 7/10/2012  
Rec'd By: [Signature]  
No. 12-094-C