

**OREGON CORNER RESTORATION FORM**

Section: 9, 10, 15, 16 Township: 3N Range: 33E  
County: Umatilla Date: 3/3/2011

Corner Designation: 3N33J13 (Amended 3/19/2012)

Section corner common to Sections 9, 10, 15, 16, T3NR33E.

<input checked="" type="checkbox"/>	Condition Report Only
<input type="checkbox"/>	Not Found
<input type="checkbox"/>	Remonumented
<input type="checkbox"/>	Unrecorded
<input type="checkbox"/>	Surveyed In
<input checked="" type="checkbox"/>	Referenced Out


**Previous Renewals / Surveys, etc.**

Originally surveyed by Chaplin in 1864. He set a post in a mound of earth.  
In 1954 Gray set a railroad spike in Survey Q-526-A.  
In 1981 Krumbein found a railroad spike in Survey S-153-B.  
In 1985 Krumbein set a brass cap in LCR J13-86-76R.


**Monuments and Accessories Found: (Condition and Source):**

A 2 1/2" brass cap, 8" below the surface.

**Diagram**

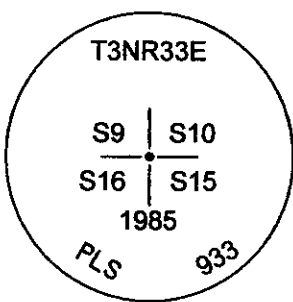

**Sketch**

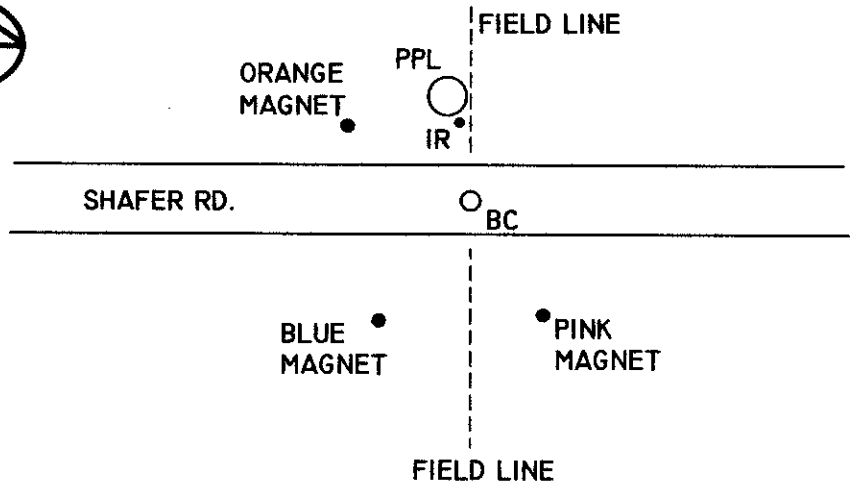

NAD 83/91  
OREGON STATE PLANE NORTH  
INTERNATIONAL FEET

N763564.33  
E8665803.27

**Monument(s) Set (Procedures and Description):**

None.

**References Set:**

"Deep One" magnets by Berntsen.  
An orange magnet lies N 46° 20' W, 27.72', 1.4' deep.  
A 5/8" x 30" iron rebar w/RPC #43406 lies N 0° 40' W, 16.27', at a power pole.  
A pink magnet lies S 26° E, 32.50', 1.6' deep.  
A blue magnet lies S 47° 20' W, 33.84', 1.5' deep.

**Location and Comments:**

The corner is 1 1/2 miles West of the intersection of Helix Hwy. and Shafer Rd., in the middle of Shafer Rd.

**Compass Declination**

17° E

**Surveyors Seal**

REGISTERED  
PROFESSIONAL  
LAND SURVEYOR

*Robert D. English*  
OREGON  
JANUARY 11, 2005  
ROBERT DOUGLAS ENGLISH  
43406LS

RENEWAL DATE: 12/31/13

**RECEIVED BY:**

Date: 7/10/2012  
Rec'd By: [Signature]  
No. 12-094-C

**Firm / Agency**

Survey One, LLC.  
P.O. Box 382  
Pendleton, OR 97801  
(541) 276-2055