

OREGON CORNER RESTORATION FORM

Section: 10, 11, 14, 15 Township: 3N Range: 33E
County: Umatilla Date: 2/18/2011

Corner Designation: 3N33J17 (Amended 3/28/2012)

Section corner common to Sections 10, 11, 14, 15, T3NR33E.

<input checked="" type="checkbox"/>	Condition Report Only
<input type="checkbox"/>	Not Found
<input type="checkbox"/>	Remonumented
<input type="checkbox"/>	Unrecorded
<input type="checkbox"/>	Surveyed In
<input checked="" type="checkbox"/>	Referenced Out


Previous Renewals / Surveys, etc.

Originally surveyed by Chaplin in 1864. He set a post in a mound of earth.
In 1988 W. Wells set a 1 1/2" x 30" galvanized iron pipe with a 2 1/2" brass cap.
In 2008 Stockhoff recovered a 2 1/2" brass cap on a 1 1/2" x 30" galvanized iron pipe.


Monuments and Accessories Found: (Condition and Source):

A 2 1/2" brass cap, stamped as shown below, 11" below the surface.

Diagram

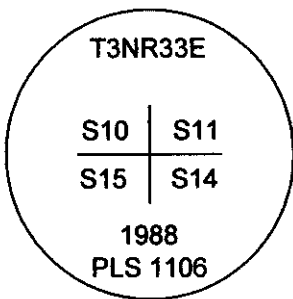

Sketch

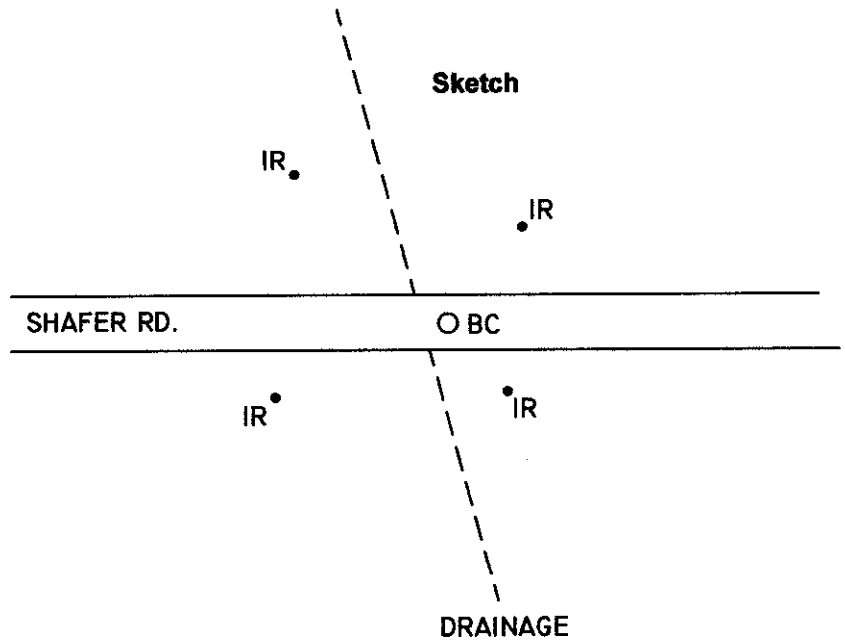

NAD 83/91
OREGON STATE PLANE NORTH
INTERNATIONAL FEET

N763668.71
E8671080.13

Monument(s) Set (Procedures and Description):

None.

References Set:

- A 5/8" x 30" iron rebar w/RPC #43406 lies N 46° 50' W, 55.51'.
- A 5/8" x 30" iron rebar w/RPC #43406 lies N 37° 50' E, 31.53', 17" deep.
- A 5/8" x 30" iron rebar w/RPC #43406 lies S 41° E, 23.38'.
- A 5/8" x 30" iron rebar w/RPC #43406 lies S 67° 10' W, 48.01'.

Location and Comments:

The corner is located 1/2 mile West of the intersection of Shafer Rd. and Helix Hwy.

Compass Declination

17° E

Surveyors Seal

REGISTERED
PROFESSIONAL
LAND SURVEYOR

Robert D. English
OREGON
JANUARY 11, 2005
ROBERT DOUGLAS ENGLISH
43406LS

RENEWAL DATE: 12/31/13

RECEIVED BY:

Date: 2/19/2012
Rec'd By: [Signature]
No. 12-094-C

Firm / Agency

Survey One, LLC.
P.O. Box 382
Pendleton, OR 97801
(541) 276-2055