

OREGON CORNER RESTORATION FORM

Section 11,14 Township 3N
County Umatilla Date: 03/23/11

Range 33E

Corner Designation: 3N33J19

Corner common to section 11 and 14 T3NR33E.

- Condition Report Only
- Not Found
- Remonumented
- Unrecorded
- Surveyed In
- Referenced Out


Previous Renewals / Surveys, etc.

Originally Surveyed by Chaplin in 1864. He set a post in a mound of earth. 1988, Wells set a 2 1/2" brass cap in survey 88-17-B.


Monuments and Accessories Found: (Condition and Source)

A 2 1/2" brass capped monument stamped as shown below, in a monument box.

Diagram

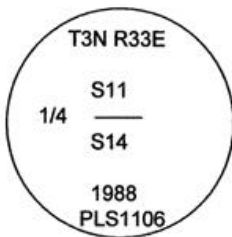

Sketch

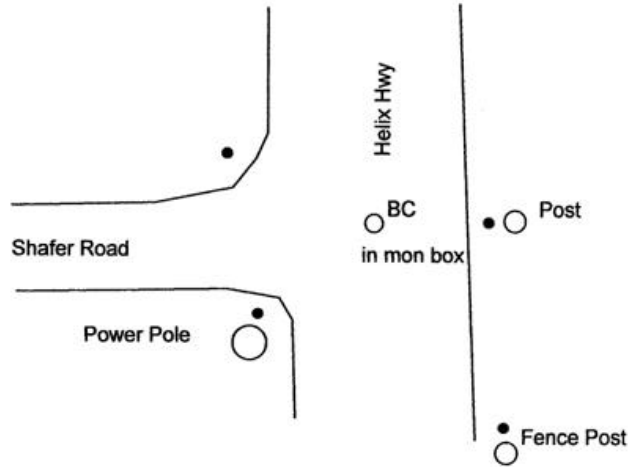

NAD 83/91
OREGON STATE PLANE NORTH
INTERNATIONAL FEET

N763732.45
E8673727.23

Monument (s) Set (Procedures and Description)

None.

References Set:

- A 5/8" x 30" iron rebar w/rpc #43406, lies N 83°20' E, 23.16'.
- A 5/8" x 30" iron rebar w/rpc #43406, lies S 17°30' E, 91.01'.
- A 5/8" x 30" iron rebar w/rpc #43406, lies S 43°10' W, 35.42'.
- A 5/8" x 30" iron rebar w/rpc #43406, lies N 54° W, 44.34'

Location and Comments

The corner is in the intersection of Shafer Road and Helix Hwy.

Compass Declination

17° E

Surveyors Seal

REGISTERED
PROFESSIONAL
LAND SURVEYOR

Robert D. English
 OREGON
 JANUARY 11, 2005
 ROBERT DOUGLAS ENGLISH
 43406LS

RENEWAL DATE: 12/31/11

RECEIVED BY:

Date: _____
 Rec'd By: _____
 No. _____

Firm / Agency

Survey One, LLC.
 P.O. Box 382
 Pendleton, OR 97801
 (541) 276-2055