

OREGON CORNER RESTORATION FORM

Section: 11, 12, 13, 14 Township: 3N Range: 33E
County: Umatilla Date: 2/8/2012

Corner Designation: 3N33J21

Section corner common to Sections 11, 12, 13, 14, T3NR33E.

_____	Condition Report Only
X	Not Found
X	Remonumented
_____	Unrecorded
X	Surveyed In
X	Referenced Out


Previous Renewals / Surveys, etc.

Originally surveyed by Chaplin in 1864. He set a post in a mound of earth, with charred stake and pits. In 1885 Zahner found the corner in an unnumbered Private Survey as recorded in Book 1, pp. 98-99. In 1899 J. Kimbrell found the corner in Private Survey No. 113, as recorded in Book 1, pg. 420.

Monuments and Accessories Found: (Condition and Source):


None.

Diagram

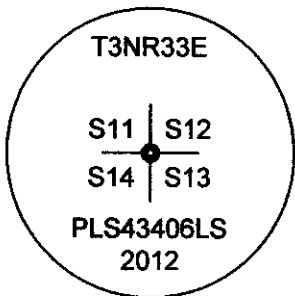

ORANGE
MAGNET

Sketch

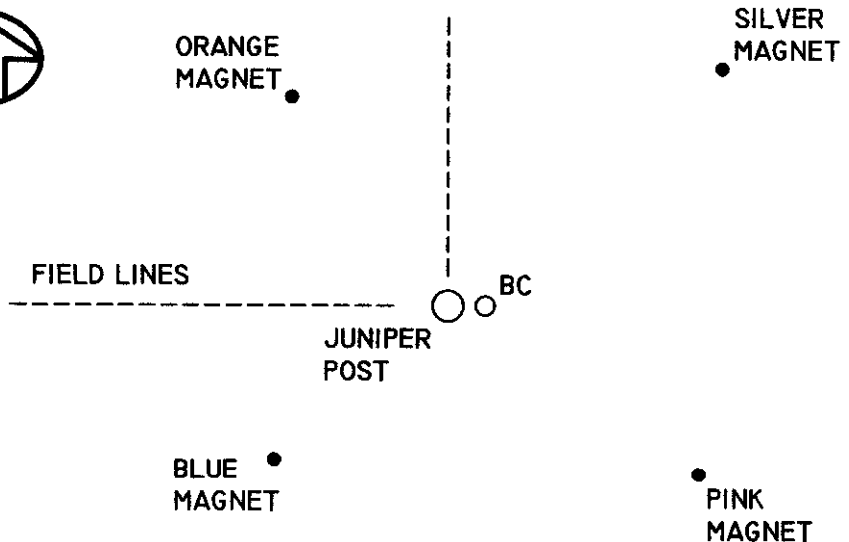

NAD 83/91
OREGON STATE PLANE NORTH
INTERNATIONAL FEET

N763820.78
E8676379.46

Monument(s) Set (Procedures and Description):

A 1 1/8" x 30" galvanized iron pipe with 2 1/2" brass cap, stamped as shown above, flush with the surface. Corner location was reestablished at the location of an old juniper post which lies at the intersection of field lines from the North and West. This position matches well with a calculated position.

References Set:

- "Deep One" magnets by Berntsen.
- An orange magnet lies N 42° 30' W, 29.55', 1.6' deep.
- A silver magnet lies N 45° 45' E, 34.97', 1.6' deep.
- A pink magnet lies S 50° 45' E, 28.20', 1.7' deep.
- A blue magnet lies S 55° 10' W, 26.95', 1.6' deep.

Location and Comments:

The corner is located 1/2 mile East of the intersection of the Helix Hwy. and Shafer Rd.

Compass Declination

17° E

Surveyors Seal

REGISTERED
PROFESSIONAL
LAND SURVEYOR

Robert D. English

OREGON
JANUARY 11, 2005
ROBERT DOUGLAS ENGLISH
43406LS

RENEWAL DATE: 12/31/13

RECEIVED BY:

Firm / Agency

Date: 2/10/2012
Rec'd By: A. Oles
No. 12-094-C

Survey One, LLC.
P.O. Box 382
Pendleton, OR 97801
(541) 276-2055