

OREGON CORNER RESTORATION FORM

Section: 12, 13 Township: 3N Range: 33E
 County: Umatilla Date: 3/8/2012

Corner Designation: 3N33J23

Quarter corner common to Sections 12, 13, T3NR33E.

	Condition Report Only
X	Not Found
X	Remonumented
	Unrecorded
X	Surveyed In
X	Referenced Out


Previous Renewals / Surveys, etc.

Originally surveyed by Chaplin in 1864. He set a post in a mound of earth, with charred stake and pits.


Monuments and Accessories Found: (Condition and Source):

None.

Diagram

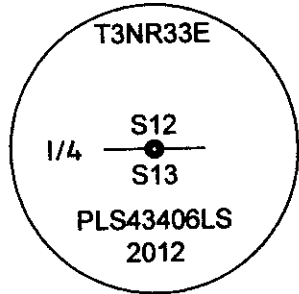

Sketch

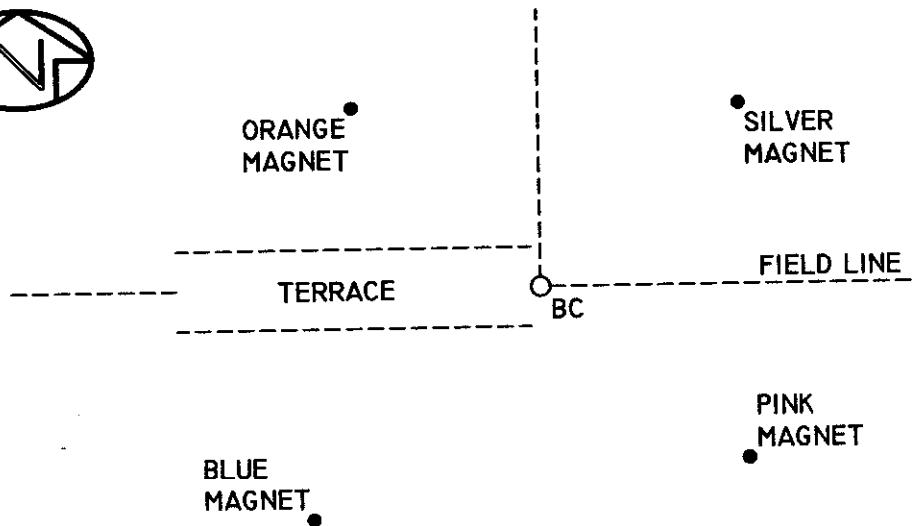

NAD 83/91
 OREGON STATE PLANE NORTH
 INTERNATIONAL FEET

N763902.97
 E8678956.57

Monument(s) Set (Procedures and Description):

A 1 1/8" x 30" galvanized iron pipe with 2 1/2" brass cap, stamped as shown above, 1.5' below the surface. The corner location was reestablished by holding the East-West line between neighboring corners and then holding the Easting of a very old steel fence post at the intersection of field lines from the North and East.

References Set:

- "Deep One" magnets by Berntsen.
- An orange magnet lies N 45° 30' W, 26.92', 1.7' deep.
- A silver magnet lies N 49° 10' E, 28.03', 1.7' deep.
- A pink magnet lies S 48° 45' E, 29.84', 1.8' deep.
- A blue magnet lies S 45° 40' W, 33.79', 1.7' deep.

Location and Comments:

The corner is located 1 mile East of the intersection of Shafer Rd. and the Helix Hwy.

Compass Declination

17° E

Surveyors Seal

REGISTERED
 PROFESSIONAL
 LAND SURVEYOR

Robert D. English

OREGON
 JANUARY 11, 2005
 ROBERT DOUGLAS ENGLISH
 43406LS

RENEWAL DATE: 12/31/13

RECEIVED BY:

Date: 7/10/2012
 Rec'd By: [Signature]
 No. 12-094-C

Firm / Agency

Survey One, LLC.
 P.O. Box 382
 Pendleton, OR 97801
 (541) 276-2055