

**OREGON CORNER RESTORATION FORM**

Section: 7, 18 Township: 3N Range: 33E  
County: Umatilla Date: 5/16/2011

Corner Designation: 3N33J03

Quarter corner common to Sections 7, 18, T3NR33E.

	Condition Report Only
X	Not Found
X	Remonumented
	Unrecorded
X	Surveyed In
X	Referenced Out


Previous Renewals / Surveys, etc.

Originally surveyed by Chaplin in 1864. He set a post in a mound of earth.


Monuments and Accessories Found: (Condition and Source):

None.

Diagram

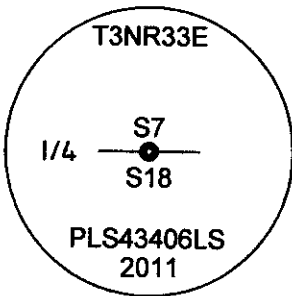

Sketch

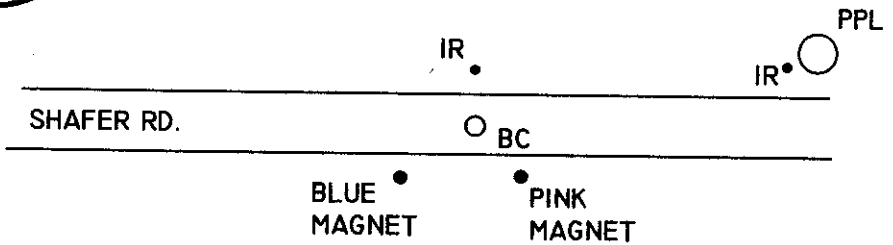

NAD 83/91  
OREGON STATE PLANE NORTH  
INTERNATIONAL FEET

N763362.31  
E8652498.03

Monument(s) Set (Procedures and Description):

A 1 1/8" x 30" galvanized iron pipe with a 2 1/2" brass cap, stamped as shown above. Corner location was reestablished by holding an old post at the South end of a North-South field line and the centerline of Shafer Road, per Umatilla County Road Notes, as the best evidence of the original location. I have found "posts" to be common at corner locations in this township.

References Set:

- "Deep One" magnets by Bermtsen.
- A 5/8" x 30" iron rebar w/RPC #43406 lies N 0° 15' W, 16.42', at a railroad tie post.
- A 5/8" x 30" iron rebar w/RPC #43406 lies N 78° 50' E, 94.80', at a power pole.
- A pink magnet lies S 42° E, 21.62', 1.1' deep.
- A blue magnet lies S 54° W, 28.26', 1.2' deep.

Location and Comments:

The corner is located 1/2 mile East of the intersection of Shafer Rd. and McCormach Rd.

Compass Declination

17° E

Surveyors Seal

REGISTERED  
PROFESSIONAL  
LAND SURVEYOR

*Robert D. English*  
OREGON  
JANUARY 11, 2005  
ROBERT DOUGLAS ENGLISH  
43406LS

RENEWAL DATE: 12/31/13

RECEIVED BY:

Firm / Agency

Date: 7/10/2012  
Rec'd By: S. Oles  
No. 12-094-C

Survey One, LLC.  
P.O. Box 382  
Pendleton, OR 97801  
(541) 276-2055