

OREGON CORNER RESTORATION FORM

Section: 8, 17
County: Umatilla

Township: 3N
Date: 5/16/2011

Range: 33E

Corner Designation: 3N33J07

Quarter corner common to Sections 8, 17, T3NR33E.

_____	Condition Report Only
<u> X </u>	Not Found
<u> X </u>	Remonumented
_____	Unrecorded
<u> X </u>	Surveyed In
<u> X </u>	Referenced Out


Previous Renewals / Surveys, etc.

Originally surveyed by Chaplin in 1864. He set a post in a mound of earth.


Monuments and Accessories Found: (Condition and Source):

None.

Diagram

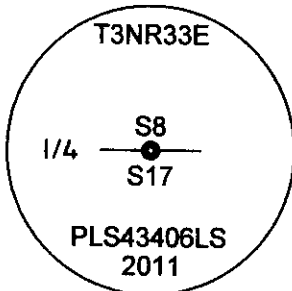

Sketch

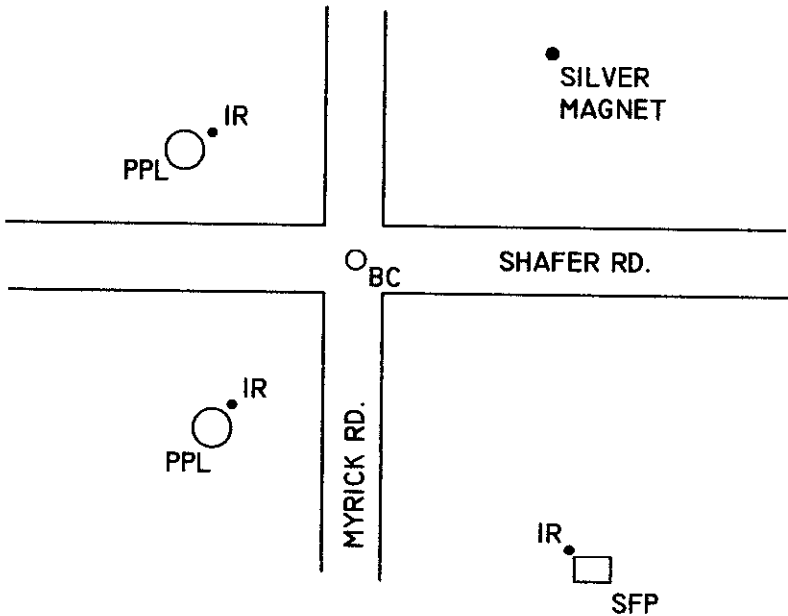

NAD 83/91
OREGON STATE PLANE NORTH
INTERNATIONAL FEET

N763449.75
E8657823.64

Monument(s) Set (Procedures and Description):

A 1 1/8" x 30" galvanized iron pipe with a 2 1/2" brass cap, stamped as shown above, 1' below the surface. Holding Umatilla County Road Notes as the best evidence, reestablished the corner in the center of the intersection of Shafer Rd. and Myrick Rd.

References Set:

- "Deep One" magnet by Berntsen.
- A 5/8" x 30" iron rebar w/RPC #43406 lies N 48° 30' W, 30.10', at a power pole.
- A silver magnet lies N 42° 40' E, 39.24', 1.5' deep.
- A 5/8" x 30" iron rebar w/RPC #43406 lies S 36° 45' E, 42.57', at a steel fence post.
- A 5/8" x 30" iron rebar w/RPC #43406 lies S 40° 15' W, 34.30', at a power pole.

Location and Comments:

The corner is located at the center of the intersection of Shafer Rd. and Myrick Rd.

Compass Declination

17° E

Surveyors Seal

REGISTERED
PROFESSIONAL
LAND SURVEYOR

Robert D. English
OREGON
JANUARY 11, 2005
ROBERT DOUGLAS ENGLISH
43406LS

RENEWAL DATE: 12/31/13

RECEIVED BY:

Firm / Agency

Date: 7/10/2012
Rec'd By: A. Dick
No. 12-094-C

Survey One, LLC.
P.O. Box 382
Pendleton, OR 97801
(541) 276-2055