

OREGON CORNER RESTORATION FORM

Section 16 Township 3N
County Umatilla Date: 03/22/11

Range 33E

Corner Designation: 3N33L13

1/4 Corner common to sections 15 and 16, T3NR33E.

_____	Condition Report Only
X	Not Found
X	Re monumented
_____	Unrecorded
X	Surveyed In
X	Referenced Out

Previous Renewals / Surveys, etc.

Originally Surveyed by Chaplin in 1864. He set a post in a mound of earth.


Monuments and Accessories Found: (Condition and Source)

None.

Diagram



Sketch

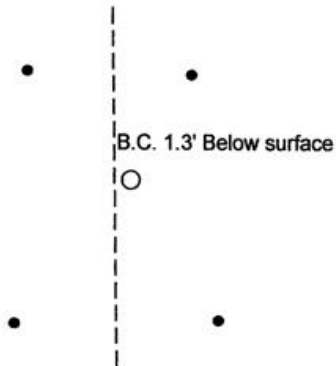

NAD 83/91
OREGON STATE PLANE NORTH
INTERNATIONAL FEET

N760942.35
E8665864.43

Monument (s) Set (Procedures and Description)

A 1 1/8" x 30" galvanized iron pipe with a 2 1/2" brass cap, stamped as shown above. Corner reestablished by single proportionate method between corners North and South.

References Set: "Deep One" magnets by Berntsen.

- A Silver magnet, 18" deep, lies N 48° E, 18.92'.
- A Pink magnet, 18" deep, lies S 35°40' E, 24.98'.
- A Blue magnet, 19" deep, lies S 38°30' W, 28.13'.
- An Orange magnet, 19" deep, lies N 53°20' W, 24.43'.

Location and Comments

The corner is 1.5 miles East of the intersection of Shafer Road and Myrick Road and South 0.5 miles.

Compass Declination

17° E

Surveyors Seal

REGISTERED
PROFESSIONAL
LAND SURVEYOR

Robert D. English
OREGON
JANUARY 11, 2005
ROBERT DOUGLAS ENGLISH
43406LS

RENEWAL DATE: 12/31/11

RECEIVED BY:

Date: _____
Rec'd By: _____
No. _____

Firm / Agency

Survey One, LLC.
P.O. Box 382
Pendleton, OR 97801
(541) 276-2055