

OREGON CORNER RESTORATION FORM

Section: 15, 16
County: Umatilla

Township: 3N
Date: 3/22/2011

Range: 33E

Corner Designation: 3N33L13 (Amended 3/14/2012)

Quarter corner common to Sections 15, 16, T3NR33E.

_____	Condition Report Only
X	Not Found
X	Remonumented
_____	Unrecorded
X	Surveyed In
X	Referenced Out


Previous Renewals / Surveys, etc.

Originally surveyed by Chaplin in 1864. He set a post in a mound of earth.


Monuments and Accessories Found: (Condition and Source):

None.

Diagram

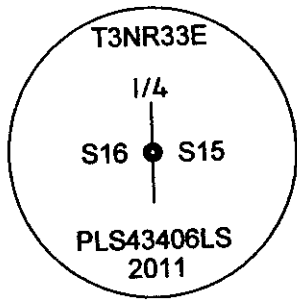

Sketch

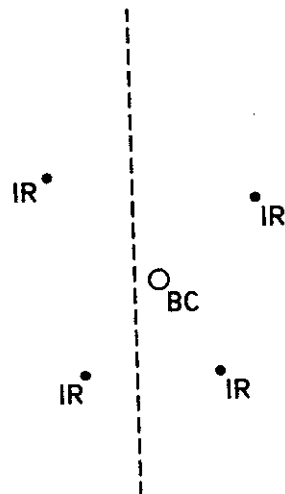

NAD 83/91
OREGON STATE PLANE NORTH
INTERNATIONAL FEET

N760941.75
E8665861.48

Monument(s) Set (Procedures and Description):

A 1 1/8" x 30" galvanized iron pipe with a 2 1/2" brass cap, stamped as shown above, at the corner reestablished by single proportionate method between the corners North and South.

References Set:

- "Deep One" magnets by Bermtsen.
- An orange magnet lies N 53° 20' W, 24.43', 1.6' deep.
- A silver magnet lies N 48° E, 18.92', 1.5' deep.
- A pink magnet lies S 35° 40' E, 24.98', 1.5' deep.
- A blue magnet lies S 38° 30' W, 28.13', 1.6' deep.

Location and Comments:

The corner is 1/2 mile South and 1 1/2 miles East of the intersection of Shafer Rd. and Myrick Rd.

Compass Declination

17° E

Surveyors Seal

REGISTERED
PROFESSIONAL
LAND SURVEYOR

Robert D. English
OREGON
JANUARY 11, 2005
ROBERT DOUGLAS ENGLISH
43406LS

RENEWAL DATE: 12/31/13

RECEIVED BY:

Date: 7/10/2012
Rec'd By: [Signature]
No. 12-094-C

Firm / Agency

Survey One, LLC.
P.O. Box 382
Pendleton, OR 97801
(541) 276-2055