

OREGON CORNER RESTORATION FORM

Section: 17, 18 Township: 3N Range: 33E
County: Umatilla Date: 5/25/2011

Corner Designation: 3N33L05

Quarter corner common to Sections 17, 18, T3NR33E.

	Condition Report Only
X	Not Found
X	Remonumented
	Unrecorded
X	Surveyed In
X	Referenced Out


Previous Renewals / Surveys, etc.

Originally surveyed by Chaplin in 1864. He set a post in a mound of earth.


Monuments and Accessories Found: (Condition and Source):

None.

Diagram

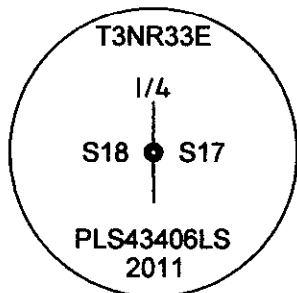

Sketch

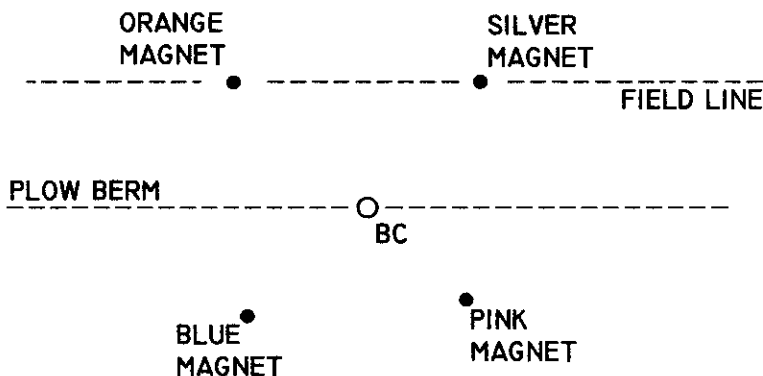

NAD 83/91
OREGON STATE PLANE NORTH
INTERNATIONAL FEET

N760782.65
E8655218.53

Monument(s) Set (Procedures and Description):

A 1 1/8" x 30" galvanized iron pipe with a 2 1/2" brass cap, stamped as shown above, 1.3' below the surface. Corner location was reestablished by a combination of holding the North-South line between found corners and holding a long established East-West plow berm.

References Set:

- "Deep One" magnets by Berntsen.
- An orange magnet lies N 47° W, 20.25', 1.3' deep.
- A silver magnet lies N 42° E, 20.27', 1.4' deep.
- A pink magnet lies S 47° E, 19.83', 1.3' deep.
- A blue magnet lies S 48° 30' W, 21.05', 1.3' deep.

Location and Comments:

The corner is located 1/2 mile South and 1/2 mile West of the intersection of Fulton Rd. and Myrick Rd.

Compass Declination

17° E

Surveyors Seal

REGISTERED
PROFESSIONAL
LAND SURVEYOR

Robert D. English

OREGON
JANUARY 11, 2005
ROBERT DOUGLAS ENGLISH
43406LS

RENEWAL DATE: 12/31/13

RECEIVED BY:

Firm / Agency

Survey One, LLC.
P.O. Box 382
Pendleton, OR 97801
(541) 276-2055

Date: 7/10/2012
Rec'd By: S. Ores
No. 12-094-C