

**OREGON CORNER RESTORATION FORM**

Section: 16, 17      Township: 3N      Range: 33E  
 County: Umatilla      Date: 5/25/2011

Corner Designation: 3N33L09

Quarter corner common to Sections 16, 17, T3NR33E.

|   |                       |
|---|-----------------------|
|   | Condition Report Only |
| X | Not Found             |
| X | Remonumented          |
|   | Unrecorded            |
| X | Surveyed In           |
| X | Referenced Out        |


**Previous Renewals / Surveys, etc.**

Originally surveyed by Chaplin in 1864. He set a post in a mound of earth.


**Monuments and Accessories Found: (Condition and Source):**

None.

**Diagram**

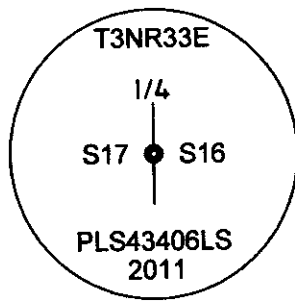

**Sketch**

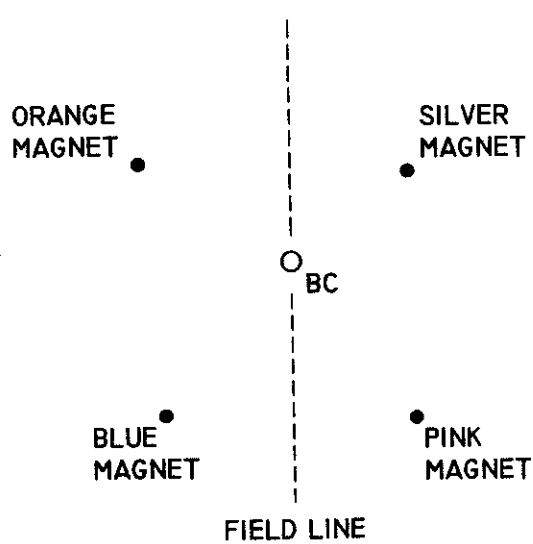

NAD 83/91  
 OREGON STATE PLANE NORTH  
 INTERNATIONAL FEET  
  
 N760841.94  
 E8660567.16

**Monument(s) Set (Procedures and Description):**

A 1 1/8" x 30" galvanized iron pipe with a 2 1/2" brass cap, stamped as shown above, 0.9' below the surface. Location of corner was reestablished by single proportionate method. Corner falls in a North-South field line.

**References Set:**

- "Deep One" magnets by Berntsen.
- An orange magnet lies N 57° 20' W, 21.78', 1.4' deep.
- A silver magnet lies N 53° E, 18.93', 1.3' deep.
- A pink magnet lies S 38° 20' E, 24.93', 1.2' deep.
- A blue magnet lies S 40° 40' W, 25.58', 1.2' deep.

**Location and Comments:**

The corner is located 1/2 mile South and 1/2 mile East of the intersection of Shafer Rd. and Myrick Rd.

**Compass Declination**

17° E

**Surveyors Seal**

REGISTERED  
 PROFESSIONAL  
 LAND SURVEYOR

*Robert D. English*  
 OREGON  
 JANUARY II, 2005  
 ROBERT DOUGLAS ENGLISH  
 43406LS

**RECEIVED BY:**

Date: 7/10/2012  
 Rec'd By: S. Oles  
 No. 12-094-C

**Firm / Agency**

Survey One, LLC.  
 P.O. Box 382  
 Pendleton, OR 97801  
 (541) 276-2055

RENEWAL DATE: 12/31/13