

OREGON CORNER RESTORATION FORM

Section: 15, 22 Township: 3N Range: 33E
County: Umatilla Date: 2/10/2012

Corner Designation: 3N33N15

Quarter corner common to Sections 15, 22, T3NR33E.

_____	Condition Report Only
_____ X	Not Found
_____ X	Remonumented
_____	Unrecorded
_____ X	Surveyed In
_____ X	Referenced Out


Previous Renewals / Surveys, etc.

Originally surveyed by Chaplin in 1864. He set a post in a mound of earth, with charred stake and pits.


Monuments and Accessories Found: (Condition and Source):

None.

Diagram

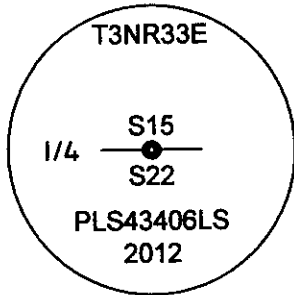

Sketch

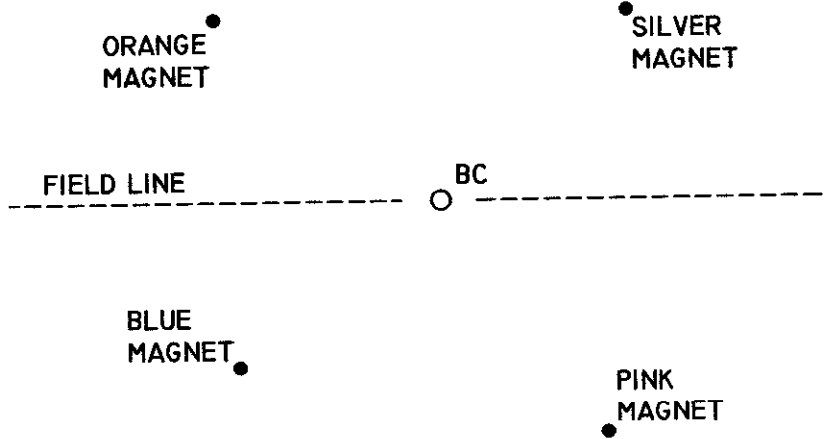

NAD 83/91
OREGON STATE PLANE NORTH
INTERNATIONAL FEET

N758366.55
E8668564.52

Monument(s) Set (Procedures and Description):

A 1 1/8" x 30" galvanized iron pipe with 2 1/2" brass cap, stamped as shown above, 1.5' below the surface. The corner location was reestablished by single proportionate method between neighboring corners to the East and West. Corner is in plowline of an active wheatfield.

References Set:

- "Deep One" magnets by Berntsen.
- An orange magnet lies N 50° 15' W, 29.95', 1.5' deep.
- A silver magnet lies N 46° E, 27.77', 1.7' deep.
- A pink magnet lies S 33° 40' E, 29.83', 1.5' deep.
- A blue magnet lies S 50° W, 27.38', 1.6' deep.

Location and Comments:

The corner is located 1 mile South and 1 mile West of the intersection of Shafer Rd. and the Helix Hwy., in a field line.

Compass Declination

17° E

Surveyors Seal

REGISTERED
PROFESSIONAL
LAND SURVEYOR

Robert D. English
 OREGON
 JANUARY 11, 2005
 ROBERT DOUGLAS ENGLISH
 43406LS

RENEWAL DATE: 12/31/13

RECEIVED BY:

Firm / Agency

Survey One, LLC.
P.O. Box 382
Pendleton, OR 97801
(541) 276-2055

Date: 2/10/2012
Rec'd By: S. P. English
No. 12-094-C