

**OREGON CORNER RESTORATION FORM**

Section: 14, 15, 22, 23 Township: 3N Range: 33E  
County: Umatilla Date: 3/15/2012

Corner Designation: 3N33N17

Section corner common to Sections 14, 15, 22, 23, T3NR33E.

	Condition Report Only
X	Not Found
X	Re monumented
	Unrecorded
X	Surveyed In
X	Referenced Out


**Previous Renewals / Surveys, etc.**

Originally surveyed by Chaplin in 1864. He set a post in a mound of earth, with charred stake and pits.


**Monuments and Accessories Found: (Condition and Source):**

None.

Diagram

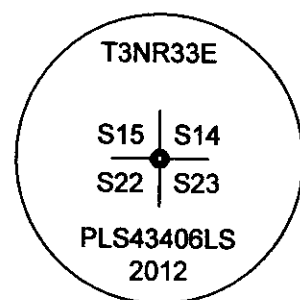

Sketch

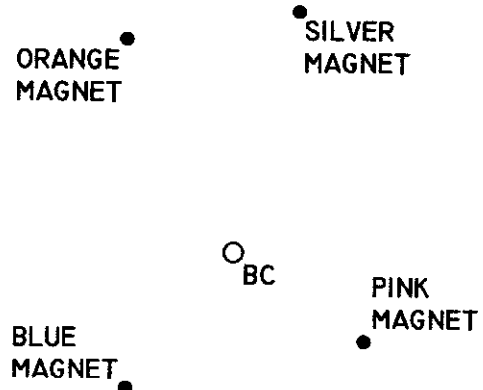

NAD 83/91  
OREGON STATE PLANE NORTH  
INTERNATIONAL FEET

N758413.96  
E8671209.98

**Monument(s) Set (Procedures and Description):**

A 1 1/8" x 30" galvanized iron pipe with 2 1/2" brass cap, stamped as shown above, 1.3' below the surface. The corner location was reestablished by double proportionate method with weight given to a 6" steel fence pipe to the West on a field line. A mound of stone at the Southwest corner of Section 15 and the 6" pipe were held for the line and the distance was proportioned.

**References Set:**

"Deep One" magnets by Berntsen.  
An orange magnet lies N 26° W, 49.88', 1.4' deep.  
A silver magnet lies N 15° 50' E, 51.91', 1.5' deep.  
A pink magnet lies S 55° 25' E, 32.97', 1.5' deep.  
A blue magnet lies S 39° 10' W, 36.33', 1.5' deep.

**Location and Comments:**

The corner is located 1 mile South and 1/2 mile West of the intersection of Shafer Rd. and the Helix Hwy., at the East end of an old plow berm.

**Compass Declination**

17° E

**Surveyors Seal**

REGISTERED  
PROFESSIONAL  
LAND SURVEYOR

*Robert D. English*  
OREGON  
JANUARY 11, 2005  
ROBERT DOUGLAS ENGLISH  
43406LS

RENEWAL DATE: 12/31/13

**RECEIVED BY:**

Date: 7/10/2012  
Rec'd By: [Signature]  
No. 12-194-C

**Firm / Agency**

Survey One, LLC.  
P.O. Box 382  
Pendleton, OR 97801  
(541) 276-2055