

**OREGON CORNER RESTORATION FORM**

Section: 14, 23  
County: Umatilla

Township: 3N  
Date: 3/14/2012

Range: 33E

Corner Designation: 3N33N19

Quarter corner common to Sections 14, 23, T3NR33E.

_____	Condition Report Only
X	Not Found
X	Remonumented
_____	Unrecorded
X	Surveyed In
X	Referenced Out


**Previous Renewals / Surveys, etc.**

Originally surveyed by Chaplin in 1864. He set a 16" x 12" x 4" stone.

**Monuments and Accessories Found: (Condition and Source):**

None.


Diagram

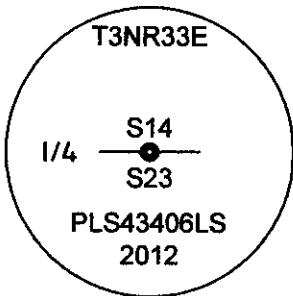

NAD 83/91  
OREGON STATE PLANE NORTH  
INTERNATIONAL FEET

N758468.65  
E8673849.82

Sketch

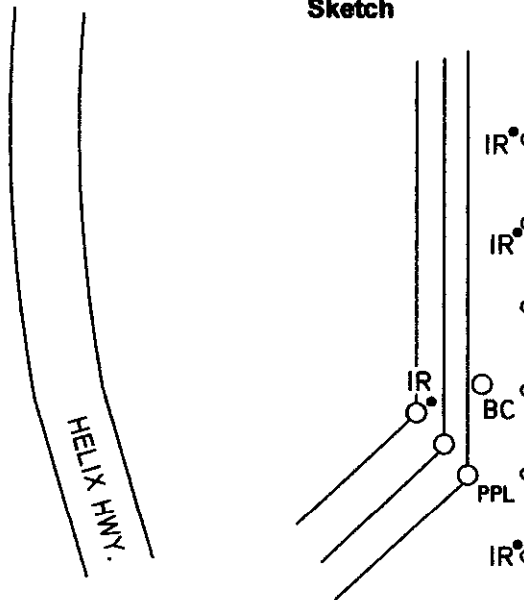

**Monument(s) Set (Procedures and Description):**

A 1 1/8" x 30" galvanized iron pipe with 2 1/2" brass cap, stamped as shown above. The corner location was reestablished by single proportionate method between neighboring corners to the East and West, approximately 15' West of existing North-South fence.

**References Set:**

- A 5/8" x 30" iron rebar w/RPC #43406 lies N 6° 20' E, 132.50', at a steel fence post.
- A 5/8" x 30" iron rebar w/RPC #43406 lies N 12° E, 81.85', at a steel fence post.
- A 5/8" x 30" iron rebar w/RPC #43406 lies S 15° 35' E, 67.88', at a steel fence post.
- A 5/8" x 30" iron rebar w/RPC #43406 lies S 71° 55' W, 27.37', at a power pole.

**Location and Comments:**

The corner is located 1/4 mile, M/L, North of the intersection of Adams Rd. and the Helix Hwy., near three power poles.

**Compass Declination**

17° E

**Surveyors Seal**

REGISTERED  
PROFESSIONAL  
LAND SURVEYOR

*Robert D. English*  
OREGON  
JANUARY 11, 2005  
ROBERT DOUGLAS ENGLISH  
43406LS

RENEWAL DATE: 12/31/13

**RECEIVED BY:**

**Firm / Agency**

Date: 7/10/2012  
Rec'd By: S. Dean  
No. 12-094-C

Survey One, LLC.  
P.O. Box 382  
Pendleton, OR 97801  
(541) 276-2055