

OREGON CORNER RESTORATION FORM

Section: 17, 20
County: Umatilla

Township: 3N
Date: 4/20/2011

Range: 33E

Corner Designation: 3N33N07

Quarter corner common to Sections 17, 20, T3NR33E.

_____	Condition Report Only
X	Not Found
X	Remonumented
_____	Unrecorded
X	Surveyed In
X	Referenced Out


Previous Renewals / Surveys, etc.

Originally surveyed by Chaplin in 1864. He set a post in a mound of earth.


Monuments and Accessories Found: (Condition and Source):

None.

Diagram

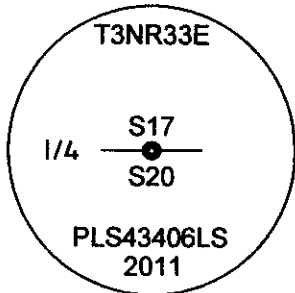

Sketch

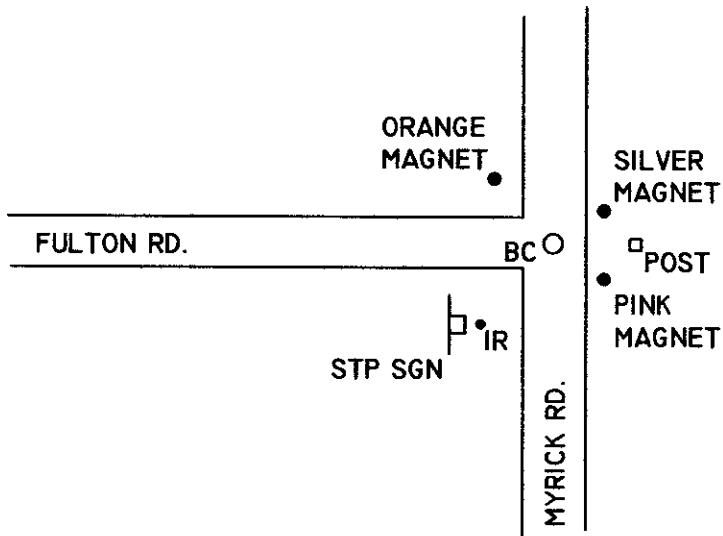

NAD 83/91
OREGON STATE PLANE NORTH
INTERNATIONAL FEET

N758171.47
E8657958.52

Monument(s) Set (Procedures and Description):

A 1 1/8" x 30" galvanized iron pipe with a 2 1/2" brass cap, stamped as shown above, 1.0' below the surface. The corner location was reestablished by holding the centerline intersect of Fulton Rd. and Myrick Rd, per Umatilla County Road Notes, as the best evidence of the original corner position.

References Set:

- "Deep One" magnets by Bermtsen.
- An orange magnet lies N 44° 20' W, 45.21', 1.6' deep.
- A silver magnet lies N 45° 30' E, 29.65', 1.3' deep.
- A pink magnet lies S 52° E, 27.38', 1.1' deep.
- A 5/8" x 30" iron rebar w/RPC #43406 lies S 35° 20' W, 45.45', at a stop sign.

Location and Comments:

The corner is located at the intersection of Fulton Rd. and Myrick Rd.

Compass Declination

17° E

Surveyors Seal

REGISTERED
PROFESSIONAL
LAND SURVEYOR

Robert D. English
OREGON
JANUARY 11, 2005
ROBERT DOUGLAS ENGLISH
43406LS

RENEWAL DATE: 12/31/13

RECEIVED BY:

Firm / Agency

Date: 7/10/2012
Rec'd By: S. Pres
No. 12-094-C

Survey One, LLC.
P.O. Box 382
Pendleton, OR 97801
(541) 276-2055