

**OREGON CORNER RESTORATION FORM**

Section: 20, 21 Township: 3N Range: 33E  
County: Umatilla Date: 3/17/2011

Corner Designation: 3N33P09 (Amended 3/13/2012)

Quarter corner common to Sections 20, 21, T3NR33E.

	Condition Report Only
X	Not Found
X	Remonumented
	Unrecorded
X	Surveyed In
X	Referenced Out


**Previous Renewals / Surveys, etc.**

Originally surveyed by Chaplin in 1864. He set a post in a mound of earth.


**Monuments and Accessories Found: (Condition and Source):**

None.

Diagram

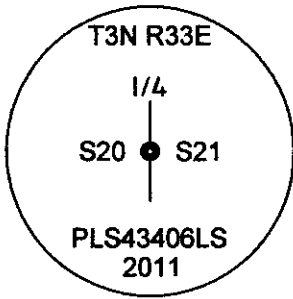

Sketch

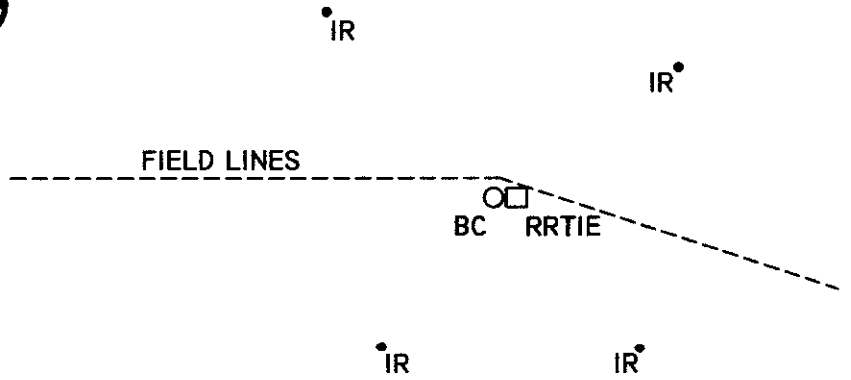

NAD 83/91  
OREGON STATE PLANE NORTH  
INTERNATIONAL FEET

N755575.25  
E8660680.58

**Monument(s) Set (Procedures and Description):**

A 1 1/8" x 30" galvanized iron pipe with a 2 1/2" brass cap at the surface, stamped as shown above, near a railroad tie post. Railroad tie post appears to match field lines and has been held as the corner between properties. I hold this position as the best evidence of the original position.

**References Set:**

- "Deep One" magnets by Berntsen.
- An orange magnet lies N 42° W, 11.45', 1.1' deep.
- A silver magnet lies N 55° 30' E, 13.31', 1.9' deep.
- A pink magnet lies S 44° E, 16.19', 1.0' deep.
- A blue magnet lies S 37° W, 13.87'.

**Location and Comments:**

The corner is located 1/2 mile South and 1/2 mile East of the intersection of Fulton Rd. and Myrick Rd.

**Compass Declination**

17° E

**Surveyors Seal**

REGISTERED  
PROFESSIONAL  
LAND SURVEYOR

*Robert D. English*  
OREGON  
JANUARY 11, 2005  
ROBERT DOUGLAS ENGLISH  
43406LS

**RECEIVED BY:**

**Firm / Agency**

Survey One, LLC.  
P.O. Box 382  
Pendleton, OR 97801  
(541) 276-2055

RENEWAL DATE: 12/31/13

Date: 7/10/2012  
Rec'd By: S. Oles  
No. 12-092-C