

OREGON CORNER RESTORATION FORM

Section: 21, 28 Township: 3N Range: 33E
County: Umatilla Date: 3/16/2012

Corner Designation: 3N33R11

Quarter corner common to Sections 21, 28, T3NR33E.

X	Condition Report Only
	Not Found
X	Remonumented
	Unrecorded
	Surveyed In
X	Referenced Out


Previous Renewals / Surveys, etc.

Originally surveyed by Chaplin in 1864. He set a 16" x 8" x 6" stone.
In 1887 Currin and Noland set a 16" x 10" x 8" basalt stone with "1/4" marked on the North face, raised a mound of earth over it, and dug pits to the East and West.


Monuments and Accessories Found: (Condition and Source):

A 23" x 9" x 8" basalt stone with a faint "1/4" chiseled into one face, 22.4' North of the calculated position.
The stone was set vertically on a very steep Southeasterly slope, 180', M/L, above Adams Rd.

Diagram

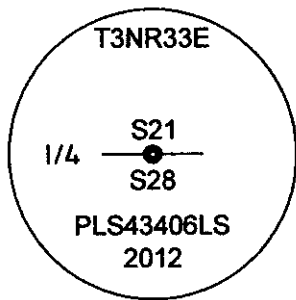

Sketch

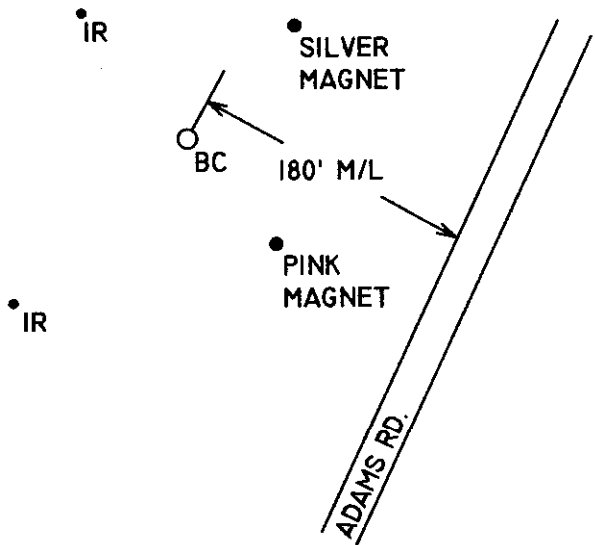

NAD 83/91
OREGON STATE PLANE NORTH
INTERNATIONAL FEET

N752999.52
E8663372.05

Monument(s) Set (Procedures and Description):

A 1 1/8" x 30" galvanized iron pipe with 2 1/2" brass cap, stamped as shown above, set in the position of the existing basalt stone, with the stone buried face down along the East side of the new monument and a mound of earth raised over them.

References Set:

- "Deep One" magnets by Berntsen.
- A 5/8" x 30" iron rebar w/RPC #43406 lies N 39° 05' W, 25.35'.
- A silver magnet lies N 45° E, 24.33', 1.8' deep.
- A pink magnet lies S 39° 05' E, 21.44', 1.6' deep.
- A 5/8" x 30" iron rebar w/RPC #43406 lies S 47° 35' W, 37.54'.

Location and Comments:

The corner is located 1.1 miles, M/L, Northeast of the intersection of Myrick Rd. and Adams Rd., on a Southeasterly facing slope

Compass Declination

17° E

Surveyors Seal

REGISTERED
PROFESSIONAL
LAND SURVEYOR

Robert D. English

OREGON
JANUARY II, 2005
ROBERT DOUGLAS ENGLISH
43406LS

RENEWAL DATE: 12/31/13

RECEIVED BY:

Date: 7/10/2012
Rec'd By: A. Pres
No. 12-094-C

Firm / Agency

Survey One, LLC.
P.O. Box 382
Pendleton, OR 97801
(541) 276-2055