

OREGON CORNER RESTORATION FORM

Section: 19, 30 Township: 3N Range: 33E
County: Umatilla Date: 3/17/2011

Corner Designation: 3N33R03 (Amended 3/13/2012)

Quarter corner common to Sections 19, 30, T3NR33E.

_____	Condition Report Only
<u> X </u>	Not Found
<u> X </u>	Remonumented
_____	Unrecorded
<u> X </u>	Surveyed In
<u> X </u>	Referenced Out


Previous Renewals / Surveys, etc.

Originally surveyed by Chaplin in 1864. He set a post in a mound of earth.


Monuments and Accessories Found: (Condition and Source):

None.

Diagram

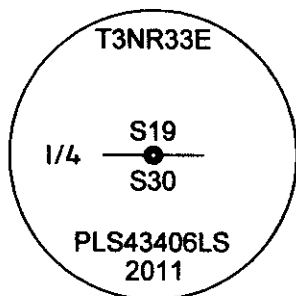

Sketch

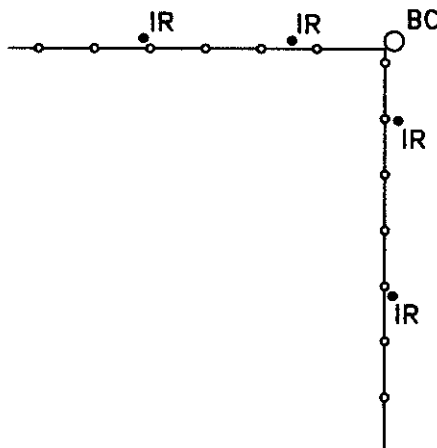

NAD 83/91
OREGON STATE PLANE NORTH
INTERNATIONAL FEET

N52809.45
E8652792.92

Monument(s) Set (Procedures and Description):

A 1 1/8" x 30" galvanized iron pipe with 2 1/2" brass cap, stamped as shown above, set at the surface. An ancient fence corner with a very good fit to the GLO record was held as the best evidence of the original corner position.

References Set:

- A 5/8" x 30" iron rebar w/RPC #43406 lies S 88° W, 45.89'.
- A 5/8" x 30" iron rebar w/RPC #43406 lies S 88° W, 20.31'.
- A 5/8" x 30" iron rebar w/RPC #43406 lies South, 23.56'.
- A 5/8" x 30" iron rebar w/RPC #43406 lies S 2° E, 8.47'.

Location and Comments:

The corner is located 1 mile South and 1/2 mile East of the intersection of Fulton Rd. and McCormach Rd.

Compass Declination

17° E

Surveyors Seal

REGISTERED
PROFESSIONAL
LAND SURVEYOR

Robert D. English
OREGON
JANUARY 11, 2005
ROBERT DOUGLAS ENGLISH
43406LS

RECEIVED BY:

Date: 7/10/2012
Rec'd By: S. Ores
No. 12-094-C

Firm / Agency

Survey One, LLC.
P.O. Box 382
Pendleton, OR 97801
(541) 276-2055

RENEWAL DATE: 12/31/13