

OREGON CORNER RESTORATION FORM

Section: 20, 29 Township: 3N Range: 33E
County: Umatilla Date: 3/18/2011

Corner Designation: 3N33R07

Quarter corner common to Sections 20, 29, T3NR33E.

_____	Condition Report Only
X	Not Found
X	Remonumented
_____	Unrecorded
X	Surveyed In
X	Referenced Out


Previous Renewals / Surveys, etc.

Originally surveyed by Chaplin in 1864. He set a post in a mound of earth with charred stake and pits. In 1882 Coffey set a post as recorded in Private Survey No. 8, Book 1, pg. 78. Questionable procedures were used when setting this post. In 1998 Krumbein set a 1" iron pipe with 2 1/2" brass cap in Survey 11-85-C. This survey was not filed until after several subsequent surveys were filed, including the corners set in our survey. This creates the distinct probability that there are double corners in the survey affected by 11-85-C.


Monuments and Accessories Found: (Condition and Source):

None.

Diagram

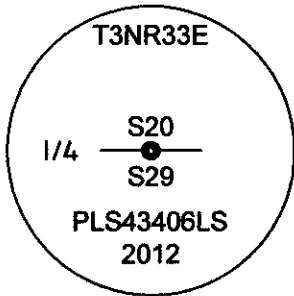

Sketch

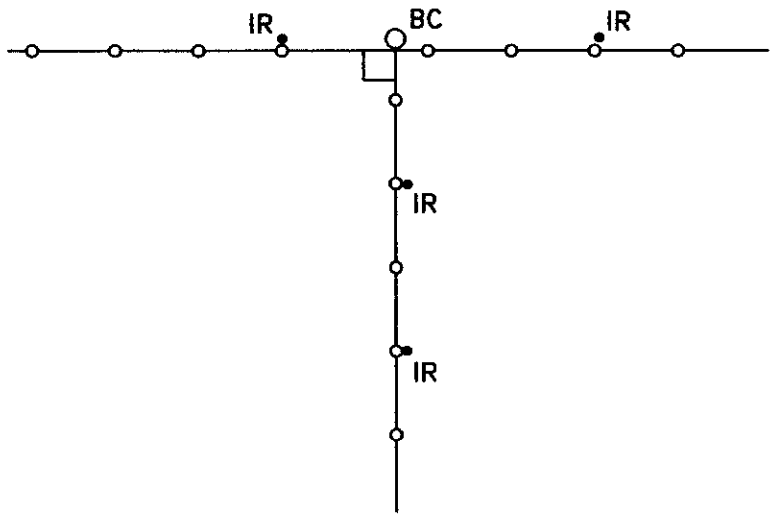

NAD 83/91
OREGON STATE PLANE NORTH
INTERNATIONAL FEET

N752866.54
E8658110.63

Monument(s) Set (Procedures and Description):

A 1 1/8" x 30" galvanized iron pipe with 2 1/2" brass cap, stamped as shown above, 2" below the surface.

References Set:

- A 5/8" x 30" iron rebar w/RPC #43406 lies N 89° 50' W, 13.99', at a fence post.
- A 5/8" x 30" iron rebar w/RPC #43406 lies S 89° E, 20.73', at a fence post.
- A 5/8" x 30" iron rebar w/RPC #43406 lies S 1° E, 11.16', at a fence post.
- A 5/8" x 30" iron rebar w/RPC #43406 lies S 1° 30' E, 35.89', at a fence post.

Location and Comments:

The corner is located 1 mile South of the intersection of Fulton Rd. and Myrick Rd, at an East-West-South fence intersection which lies 350', M/L, East of Myrick Rd.

Compass Declination

17° E

Surveyors Seal

REGISTERED
PROFESSIONAL
LAND SURVEYOR

Robert D. English

OREGON
JANUARY 11, 2005
ROBERT DOUGLAS ENGLISH
43406LS

RECEIVED BY:

Firm / Agency

Date: 7/10/2012
Rec'd By: [Signature]
No. 12-094-c

Survey One, LLC.
P.O. Box 382
Pendleton, OR 97801
(541) 276-2055

RENEWAL DATE: 12/31/13