

OREGON CORNER RESTORATION FORM

Section: 27, 28 Township: 3N Range: 33E
County: Umatilla Date: 6/8/2011

Corner Designation: 3N33T13

Quarter corner common to Sections 27, 28, T3NR33E.

<input checked="" type="checkbox"/>	Condition Report Only
<input type="checkbox"/>	Not Found
<input type="checkbox"/>	Remonumented
<input type="checkbox"/>	Unrecorded
<input type="checkbox"/>	Surveyed In
<input checked="" type="checkbox"/>	Referenced Out


Previous Renewals / Surveys, etc.

Originally surveyed by Chaplin in 1864. He set a 15" x 10" x 5" stone.
In 1871 Moody set a post and made a mound of earth.
In 1887 Currin and Noland set a 16" x 10" x 10" basalt stone, 12" in the ground.
In 1998 Krumbein set a 1" iron pipe with a 2 1/2" brass cap.
In 2001 Stratton recovered a brass cap in Survey 01-90-B.

Monuments and Accessories Found: (Condition and Source):

A 2 1/2" brass cap, stamped as shown below, 9" below the surface.

Diagram

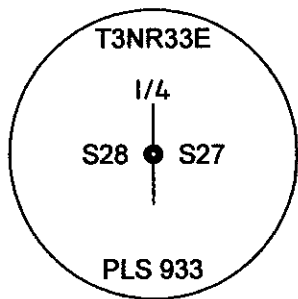


NAD 83/91
OREGON STATE PLANE NORTH
INTERNATIONAL FEET

N750373.62
E8666090.12

Monument(s) Set (Procedures and Description):

None.

Sketch

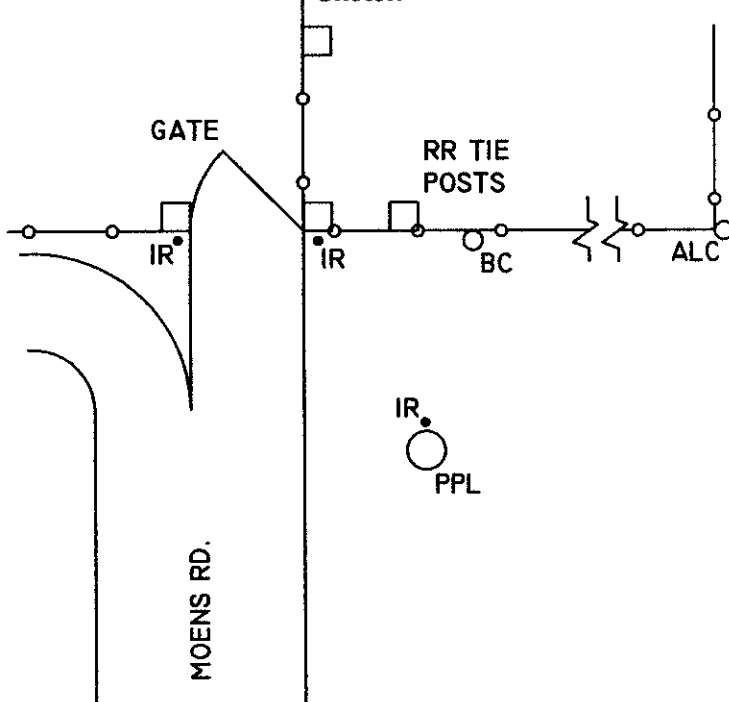

References Set:

A 5/8" x 30" iron rebar w/RPC #43406 lies S 89° W, 26.33', at a railroad tie gate post.
A 5/8" x 30" iron rebar w/RPC #43406 lies S 88° 10' W, 9.25', at a railroad tie gate post.
A 5/8" x 30" iron rebar w/RPC #43406 lies S 16° 15' W, 23.87', at a power pole.
An aluminum cap stamped w/PLS 933 lies N 88° 30' E, 185.01', at a fence corner.

Location and Comments:

The corner is located 1/2 mile North of the intersection of Hwy. 11 and Duff Rd.

Compass Declination

17° E

Surveyors Seal

REGISTERED
PROFESSIONAL
LAND SURVEYOR

Robert D. English
OREGON
JANUARY 11, 2005
ROBERT DOUGLAS ENGLISH
43406LS

RECEIVED BY:

Firm / Agency

Date: 7/10/2012
Rec'd By: S. P. Co.
No. 12-094-C

Survey One, LLC.
P.O. Box 382
Pendleton, OR 97801
(541) 276-2055

RENEWAL DATE: 12/31/13