

OREGON CORNER RESTORATION FORM

Section: 25, 26
County: Umatilla

Township: 3N
Date: 1/10/2012

Range: 33E

Corner Designation: 3N33T21

Quarter corner common to Sections 25, 26, T3NR33E.

_____	Condition Report Only
X	Not Found
X	Remonumented
_____	Unrecorded
X	Surveyed In
X	Referenced Out


Previous Renewals / Surveys, etc.

Originally surveyed by Chaplin in 1864. He set a post in a mound of earth, buried charred stake, and dug pits. In 1871 Moody set a post in a mound of earth. In 1887 Currin and Noland set a 9" x 8" x 7" basalt stone, made a mound of earth, and dug pits North and South.


Monuments and Accessories Found: (Condition and Source):

None.

Diagram

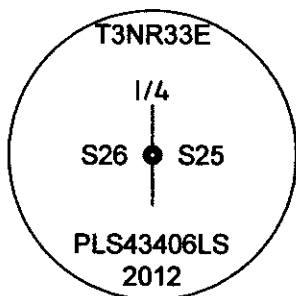

Sketch

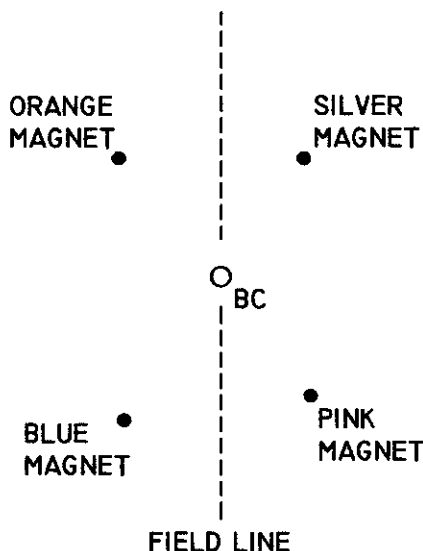

NAD 83/91
OREGON STATE PLANE NORTH
INTERNATIONAL FEET

N750610.71
E8676654.09

Monument(s) Set (Procedures and Description):

A 1 1/8" x 30" galvanized iron pipe with 2 1/2" brass cap, stamped as shown above, 1.4' below the surface. The corner location was reestablished by single proportionate method between neighboring corners to the North and South.

References Set:

- "Deep One" magnets by Berntsen.
- An orange magnet lies N40° W, 31.53', 1.5' deep.
- A silver magnet lies N 36° 30' E, 30.46', 1.4' deep.
- A pink magnet lies S 36° 40' E, 30.88', 1.7' deep.
- A blue magnet lies S 35° W, 35.83', 1.7' deep.

Location and Comments:

The corner is located 2/3 mile South East of the intersection of Hwy. 11 and the Helix Hwy.

Compass Declination

17° E

Surveyors Seal

REGISTERED
PROFESSIONAL
LAND SURVEYOR

Robert D. English
OREGON
JANUARY 11, 2005
ROBERT DOUGLAS ENGLISH
43406LS

RECEIVED BY:

Firm / Agency

Date: 7/10/2012
Rec'd By: S. Oles
No. 12-094-C

Survey One, LLC.
P.O. Box 382
Pendleton, OR 97801
(541) 276-2055

RENEWAL DATE: 12/31/13