

**OREGON CORNER RESTORATION FORM**

Section: 27, 28, 33, 34 Township: 3N Range: 33E  
 County: Umatilla Date: 3/20/2012

Corner Designation: 3N33V13

Section corner common to Sections 27, 28, 33, 34, T3NR33E.

	Condition Report Only
X	Not Found
X	Remonumented
	Unrecorded
X	Surveyed In
X	Referenced Out


**Previous Renewals / Surveys, etc.**

Originally surveyed by Chaplin in 1864. He set a post in a mound of earth, with charred stake and pits.  
 In 1871 Moody set a post in a mound of earth.  
 In 1887 Currin and Noland buried charred stake at the corner location, raised a mound of earth, dug pits in each section, and set a stake in the Southeast pit.  
 In 1902 MaComber found a stone in Private Survey No. 135 as recorded in Book1, pp. 458-459.  
 In 1998 Krumbein set a brass cap in Survey 11-85-C. This survey was not filed until after several subsequent surveys were filed, including the corners set in our survey. This creates the distinct probability that there are double corners in the survey affected by 11-85-C.


**Monuments and Accessories Found: (Condition and Source):**

None.

Diagram

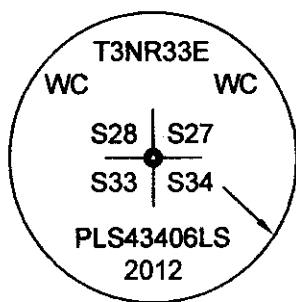

Sketch

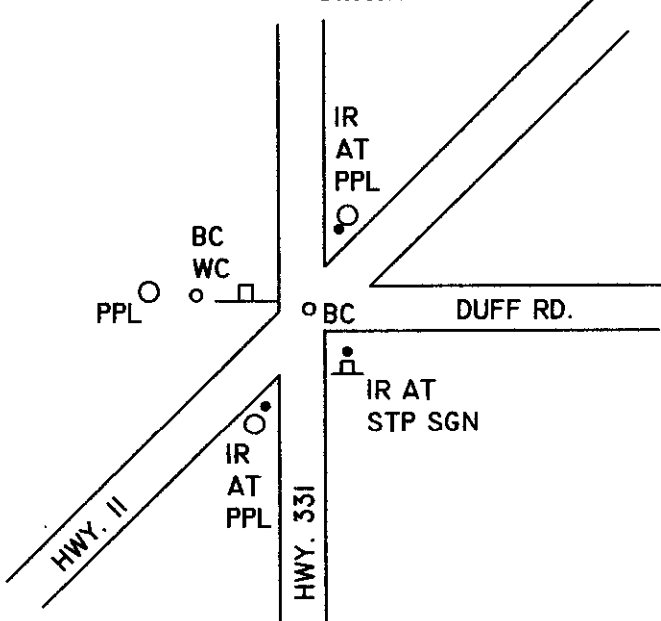

NAD 83/91  
 OREGON STATE PLANE NORTH  
 INTERNATIONAL FEET

N747735.36  
 E8666125.77

**Monument(s) Set (Procedures and Description):**

A PK Nail at the corner position, in the intersection of Hwy. 11 and Hwy. 331.  
 The corner location was reestablished by holding ODOT measurements from the South to the Section corner and from the West to the Quarter corner.

**References Set:**

- A 2 1/2" brass cap witness corner, stamped as shown above, lies N 44° W, 53.73', between a power pole and a concrete sign base.
- A 5/8" x 30" iron rebar w/RPC #43406 lies N 9° 30' E, 85.20', at a power pole.
- A 5/8" x 30" iron rebar w/RPC #43406 lies S 16° 30' E, 66.29', at a stop sign.
- A 5/8" x 30" iron rebar w/RPC #43406 lies S 34° 50' W, 113.33', at a power pole.

**Location and Comments:**

The corner is located in the intersection of Hwy. 11 and Hwy. 331.

**Compass Declination**

17° E

**Surveyors Seal**

REGISTERED  
 PROFESSIONAL  
 LAND SURVEYOR

*Robert D. English*

OREGON  
 JANUARY 11, 2005  
 ROBERT DOUGLAS ENGLISH  
 43406LS

RENEWAL DATE: 12/31/13

**RECEIVED BY:**

Date: 7/10/2012  
 Rec'd By: S. Oler  
 No. 12-094-C

**Firm / Agency**

Survey One, LLC.  
 P.O. Box 382  
 Pendleton, OR 97801  
 (541) 276-2055