

OREGON CORNER RESTORATION FORM

Section: 33, 34
County: Umatilla

Township: 3N
Date: 3/21/2012

Range: 33E

Corner Designation: 3N33X13

Quarter corner common to Sections 33, 34, T3NR33E.

_____	Condition Report Only
<u> X </u>	Not Found
<u> X </u>	Remonumented
_____	Unrecorded
<u> X </u>	Surveyed In
<u> X </u>	Referenced Out


Previous Renewals / Surveys, etc.

Originally surveyed by Chaplin in 1864. He set a post in a mound of earth, with charred stake and pits.
In 1871 Moody set a post in a mound of earth.
In 1887 Currin and Noland set a stake in a mound of earth, with charred stake and pits to the North and South.
In 1902 MaComber set a 14" x 6" x 8" stone in Private Survey No. 135 as recorded in Book 1, pp. 458-459.


Monuments and Accessories Found: (Condition and Source):

None.

Diagram

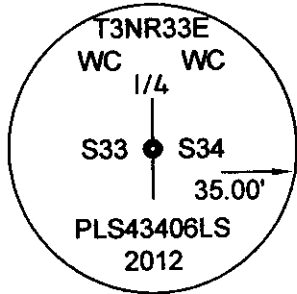

Sketch

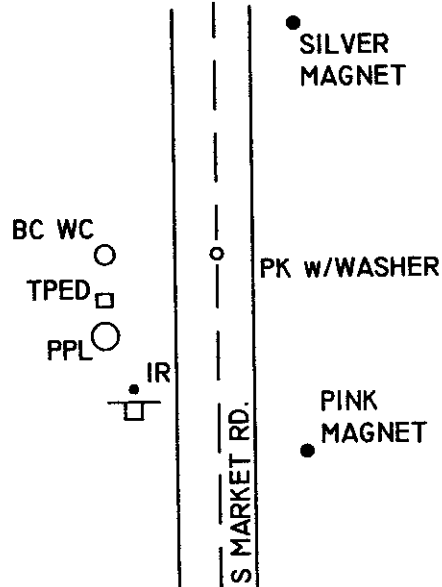

NAD 83/91
OREGON STATE PLANE NORTH
INTERNATIONAL FEET

N745081.59
E8666199.08

Monument(s) Set (Procedures and Description):

A PK Nail w/ 1 1/2" washer at the corner position on the centerline of South Market Rd.
The corner location was reestablished by single proportionate method between neighboring corners to the North and South.

References Set:

- "Deep One" magnets by Berntsen.
- A silver magnet lies N 19° 30' E, 76.17', 1.7' deep.
- A pink magnet lies S 22° 50' E, 67.19', 1.6' deep.
- A 5/8" x 30" iron rebar w/ RPC #43406 lies S 38° W, 41.98', at a road sign.
- A 2 1/2" brass cap Witness Corner lies West, 35.01', 0.5' deep.

Location and Comments:

The corner is located 1/2 mile South of the intersection of Hwy. 11 and South Market Rd., at the centerline of South Market Rd.

Compass Declination

17° E

Surveyors Seal

REGISTERED
PROFESSIONAL
LAND SURVEYOR

Robert D. English
OREGON
JANUARY 11, 2005
ROBERT DOUGLAS ENGLISH
43406LS

RENEWAL DATE: 12/31/13

RECEIVED BY:

Date: 2/10/2012
Rec'd By: S. Ores
No. 12-094-C

Firm / Agency

Survey One, LLC.
P.O. Box 382
Pendleton, OR 97801
(541) 276-2055