

OREGON CORNER RESTORATION FORM

Section: 34, 35
 County: Umatilla

Township: 3N
 Date: 12/20/2011

Range: 33E

Corner Designation: 3N33X17

Quarter corner common to Sections 34, 35, T3NR33E.

	Condition Report Only
X	Not Found
X	Remonumented
	Unrecorded
X	Surveyed In
X	Referenced Out


Previous Renewals / Surveys, etc.

Originally surveyed by Chaplin in 1864. He set a post in a mound of earth with charred stake and pits.
 In 1871 Moody set a post in a mound of earth.
 In 1887 Currin and Noland buried charred stake under a mound of earth, dug pits North and South, and set a stake in the North pit.


Monuments and Accessories Found: (Condition and Source):

None.

Diagram

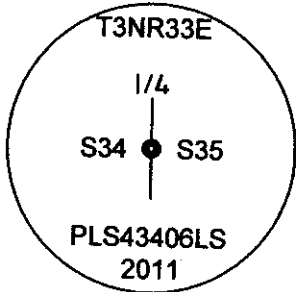

Sketch

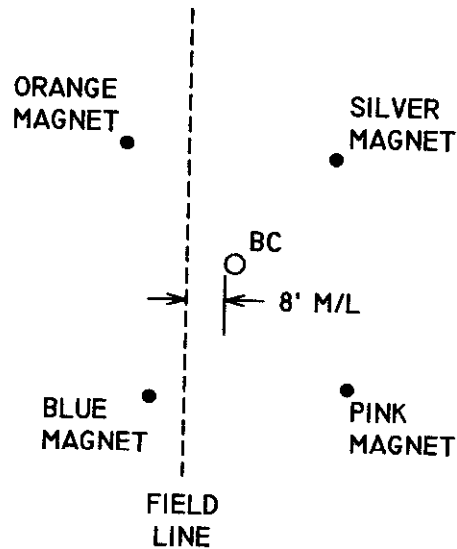

NAD 83/91
 OREGON STATE PLANE NORTH
 INTERNATIONAL FEET

N745217.49
 E8671488.28

Monument(s) Set (Procedures and Description):

A 1 1/8" x 30" galvanized iron pipe with 2 1/2" brass cap, stamped as shown above, 1.7' below the surface.
 The corner location was reestablished by single proportionate method between comers to the North and South.

References Set:

- "Deep One" magnets by Bermtsen.
- An orange magnet lies N 42° 30' W, 33.96', 1.6' deep.
- A silver magnet lies N 44° E, 30.20', 1.7' deep.
- A pink magnet lies S 41° 45' E, 34.80', 1.7' deep.
- A blue magnet lies S 32° 20' W, 32.79', 1.7' deep.

Location and Comments:

The corner is located 1/2 mile South and 1 mile East of the intersection of Hwy. 11 and South Market Rd.

Compass Declination
 17° E

Surveyors Seal

REGISTERED
 PROFESSIONAL
 LAND SURVEYOR

Robert D. English
 OREGON
 JANUARY 11, 2005
 ROBERT DOUGLAS ENGLISH
 43406LS

RENEWAL DATE: 12/31/13

RECEIVED BY:

Date: 7/10/2012
 Rec'd By: S. Pres
 No. 12-094-C

Firm / Agency

Survey One, LLC.
 P.O. Box 382
 Pendleton, OR 97801
 (541) 276-2055