

**OREGON CORNER RESTORATION FORM**

Section: 35 Township: 3N Range: 33E  
County: Umatilla Date: 12/15/2011

Corner Designation: 3N33Z19

South quarter corner of Section 35 only.

_____	Condition Report Only
<u>  X  </u>	Not Found
<u>  X  </u>	Remonumented
_____	Unrecorded
<u>  X  </u>	Surveyed In
<u>  X  </u>	Referenced Out


**Previous Renewals / Surveys, etc.**

Originally surveyed by Thompson in 1864. He set a post in a mound of earth with charred stake, pits, and a trench.  
In 1871 Moody set a post in a mound of earth.  
In 1887 Currin and Noland buried a charred stake under a mound of earth, dug pits to the East and West, and set a stake in the East pit.  
In 1887 Currin and Noland found pits and a mound.


**Monuments and Accessories Found: (Condition and Source):**

None.

Diagram

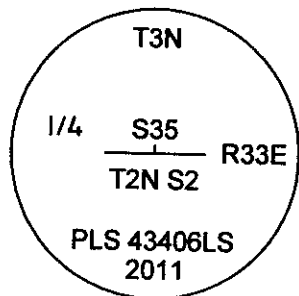

Sketch

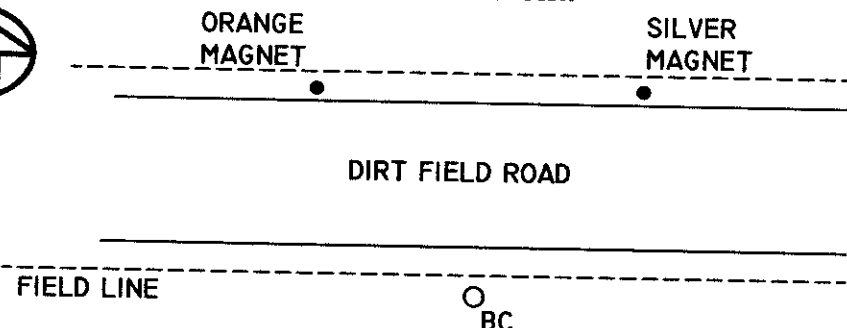

NAD 83/91  
OREGON STATE PLANE NORTH  
INTERNATIONAL FEET

N742588.35  
E8674176.27

BLUE MAGNET

PINK MAGNET

**Monument(s) Set (Procedures and Description):**

A 1 1/8" x 30" galvanized iron pipe with 2 1/2" brass cap, stamped as shown above, 1.4' below the surface. The corner location was reestablished by single proportionate method from found monuments East and West.

**References Set:**

"Deep One" magnets by Bermtsen.  
An orange magnet lies N 37° W, 27.21', 1.5' deep.  
A silver magnet lies N 40° E, 27.75', 1.5' deep.  
A pink magnet lies S 42° E, 23.16', 1.7' deep.  
A blue magnet lies S 34° 30' W, 25.47', 1.6' deep.

**Location and Comments:**

The corner is located 1 1/2 miles West of the intersection of Kirkpatrick Rd. and North Cayuse Rd.

**Compass Declination**

17° E

**Surveyors Seal**

REGISTERED  
PROFESSIONAL  
LAND SURVEYOR

*Robert D. English*  
OREGON  
JANUARY 11, 2005  
ROBERT DOUGLAS ENGLISH  
43406LS

RENEWAL DATE: 12/31/13

**RECEIVED BY:**

Date: 2/10/2014  
Rec'd By: [Signature]  
No. 12-0942

**Firm / Agency**

Survey One, LLC.  
P.O. Box 382  
Pendleton, OR 97801  
(541) 276-2055