

OREGON CORNER RESTORATION FORM

COUNTY: Umatilla DATE: 1/30/14

CORNER DESIGNATION: C-17, The West Quarter Corner of Section 2, Township 3 North, Range 34 East, W.M.

PREVIOUS RENEWALS/SURVEYS ETC.: Corner originally established by Currin and Noland under contract dated May 4th, 1887. Deposited charred stake 12" in the ground for 1/4 corner.

MONUMENT AND ACCESSORIES FOUND: None. Corner falls in a raised railroad tie flower bed.

MONUMENT MARKING DETAIL:

T3N R34E
1
4
S3|S2
2014
PLS 54657

MONUMENT SET: Set a 5/8"x24" iron rebar with 2" aluminum cap in a railroad tie raised flower bed 4" below ground level. A large tree root prevented setting a brass cap on iron pipe monument. Monument marked as shown in "Monument Marking Detail".

From which:

A 5/8"x24" iron rebar with 1 1/4" purple plastic cap marked "Wells Surveying PLS 54657" flush with ground level at the Easterly edge of a gravel driveway bears South 00°17'05" West, 135.71 feet.

A 5/8"x24" iron rebar with 1 1/4" purple plastic cap marked "Wells Surveying PLS 54657" 1" below ground level bears North 89°59'31" West, 406.04 feet.

A 3/4" brass washer stamped "PLS 1106" 12" above ground level in the Easterly face of a 10" maple tree North 80° West, 6.8 feet. Attached witness post sign to tree.

The most Southwesterly corner of a concrete house foundation at ground level bears North 75° East, 27.4 feet.


LOCATION AND COMMENTS: Corner is located in a raised flower bed 4" below ground level approximately 14' Easterly of an electric horse pasture fence running North-South.

FIRM: Wells Surveying
P.O. Box 1696
Pendleton, OR 97801

COMPASS DECLINATION: 18° East

Surveyor's Seal

/3N34C17

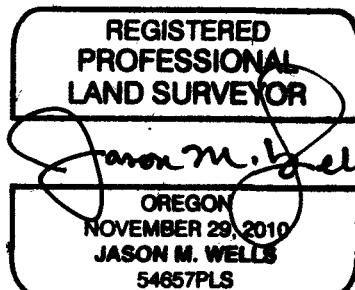

RENEWS: 6-30-14

14-014-C