

OREGON CORNER RESTORATION FORM

COUNTY: Umatilla DATE: 9/04/15

CORNER DESIGNATION: J-9, The Northeast Corner of Section 17, Township 3 North, Range 34 East, W.M.

PREVIOUS RENEWALS/SURVEYS ETC.: Corner established by Dave Krumbein PLS 933 in 1971 in Umatilla County Survey No. I-136-B. Said survey states he set a brass cap at a found fence corner. Holding the record interior angle and distance from the found Southeast and Southwest corners of Section 17, as shown on the survey filed concurrently with this certificate, the corner falls inside a 8" diameter metal casing marking a field corner with field berms North, South, and East. The Krumbein brass cap is likely inside the casing.

MONUMENT AND ACCESSORIES FOUND: None. Set a brass cap witness corner 2.0 feet Southerly on line of the record corner location for the Northeast Corner of Section 17, per survey I-136-B. See my survey filed concurrently with this certificate.

MONUMENT MARKING DETAIL:

W.C. 2.0 FT
T3N R34E
S8|S9
S17|S16
2015
PLS 54657

MONUMENT SET: Set a 2 3/8" brass cap WITNESS CORNER on 1 1/4"x30" galvanized iron pipe with the top of the monument set 2" below ground level, 2.0 feet Southerly on line of the record corner location for the Northeast Corner of Section 17, per survey I-136-B. Monument marked as shown in "Monument Marking Detail".

From which:

A 5/8"x30" iron rebar with 1 1/4" purple plastic cap stamped "Wells Surveying PLS 54657" 1" above ground level in a unfarmed field corner bears North 20° East, 16.0 feet.

A 5/8"x30" iron rebar with 1 1/4" purple plastic cap stamped "Wells Surveying PLS 54657" 1" above ground level in a unfarmed field corner bears South 86° East, 26.8 feet.

A Pink Deep-1 magnet buried 22" in the ground bears South 21° East, 33.2 feet.

A Blue Deep-1 magnet buried 22" in the ground bears South 50° West, 25.1 feet.

All accessories reference the set witness corner monument.

Buried bearing object signs with magnets and wired bearing object signs to rebar. Wired a witness post sign to the 8" diameter metal casing 2 feet North of the monument.

LOCATION AND COMMENTS: Witness corner is located 2 feet Southerly of an 8" diameter metal casing in a farmed field at the intersection of field berms North, South, and East.

APPROXIMATE OREGON NORTH ZONE (NAD83/91) STATE PLANE COORDINATES:

NORTH = 764183

EAST = 8691893

FIRM: Wells Surveying


P.O. Box 1696

Pendleton, OR 97801

COMPASS DECLINATION: 18° East

Surveyor's Seal

/3N34J9

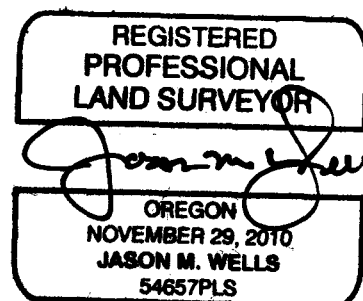

RENEWS: 6:30:16

15-088-B