

OREGON CORNER RESTORATION FORM

Section: 13, 24, 18, 29
County: Umatilla

Township: 3N
Date: 3/7/2012

Range: 33E, 34E

Corner Designation: 3N33N25

Section corner common to Sections 13, 24, T3NR33E; 18, 19, T3NR34E.

_____	Condition Report Only
_____ X	Not Found
_____ X	Remonumented
_____	Unrecorded
_____ X	Surveyed In
_____ X	Referenced Out


Previous Renewals / Surveys, etc.

Originally surveyed by Thompson in 1864. He set a post in a mound of earth, with charred stake, pits, and trench.
In 1866 Odell set a post in a mound of earth, with charred stake and pits.
In 1871 Moody set a post in a mound of earth.
In 1951 Melton found the corner in Survey Q-523-A.

Monuments and Accessories Found: (Condition and Source):

None.


Diagram

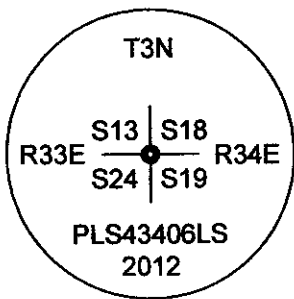

ORANGE
MAGNET

BLUE
MAGNET

Sketch

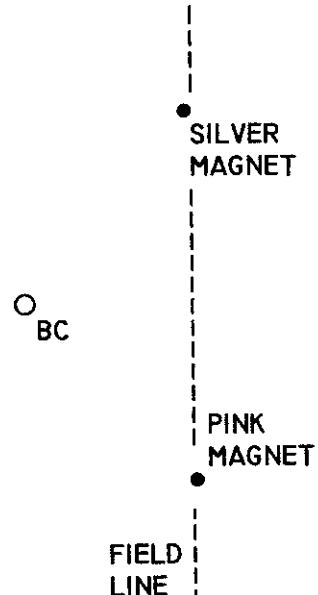

NAD 83/91
OREGON STATE PLANE NORTH
INTERNATIONAL FEET

N758689.20
E8681716.38

Monument(s) Set (Procedures and Description):

A 1 1/8" x 30" galvanized iron pipe with 2 1/2" brass cap, stamped as shown above, 1.4' below the surface. The corner location was reestablished by single proportionate method between found corners to the North and South.

References Set:

"Deep One" magnets by Berntsen.
An orange magnet lies N 43° W, 32.83', 1.7' deep.
A silver magnet lies N 41° 15' E, 26.08', 1.7' deep.
A pink magnet lies S 42° 40' E, 25.66', 1.6' deep.
A blue magnet lies S 41° 50' W, 30.46', 1.8' deep.

Location and Comments:

The corner is located 1 mile North and 1 mile West of the intersection of Tubbs Ranch Rd. and Rothrock Rd., 15', M/L, West of a North-South field line.

Compass Declination

17° E

Surveyors Seal

REGISTERED
PROFESSIONAL
LAND SURVEYOR

Robert D. English
OREGON
JANUARY 11, 2005
ROBERT DOUGLAS ENGLISH
43406LS

RENEWAL DATE: 12/31/13

RECEIVED BY:

Date: 7/10/2012
Rec'd By: S. Dea
No. 12-094-C

Firm / Agency

Survey One, LLC.
P.O. Box 382
Pendleton, OR 97801
(541) 276-2055