

OREGON CORNER RELOCATION FORM

Section 4 Township 3N Range 36E
 County Umatilla Date: July 13th, 2006

Corner Designation: 3N36C13



Condition Report Only
 Not found
 Remonumented
 Unrecorded
 Surveyed in
 Referenced out

1/4 corner to sections 3 and 4, T3N, R36E W.M.
 Umatilla County, Oregon.

Previous Renewals / Surveys, etc.

Corner originally set by George S. Pershin under contract No. 305 dated September 20, 1878.
 His record reads: Set tamarack post on level ground for 1/4 sec. cor., from which A pine, 24 in diam. brs. S. 68 E. 50 lks dist., A fir, 10 in diam. brs. S. 74 W. 95 lks. dist.

Monument and Accessories found: (condition and source)
 None: The point falls in an area that has been farmed.

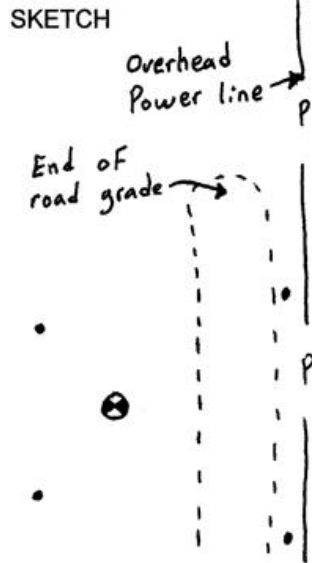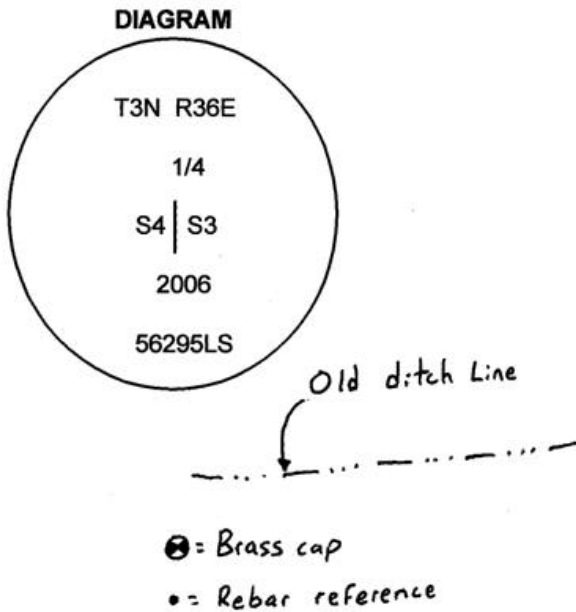

MONUMENT (S) AND ACCESSORIES SET (Procedures and Description)

Set a 1 1/4" x 30" Galvanized Iron Pipe with a 2 1/2" brass cap stamped as shown in the diagram above at the proportionate point.

For references, I set four 5/8" by 24" rebars with 1.25" orange plastic caps stamped WTS and 56295LS as described below:

- an iron rebar bears N65°25'26"W, 33.36 feet;
- an iron rebar bears N44°11'58"E, 58.89 feet;
- an iron rebar bears S31°49'50"W, 44.41 feet;
- an iron rebar bears S60°03'55"E, 72.16 feet;

This monument and references were set and tied using a Trimble R7/R8 RTK GPS.

Location and comments

Compass Declination

Surveyors Seal

RECEIVED BY:
Umatilla County Surveyor
 Date: 7-06
 Rec'd By: RK
 No. 06-472-B

Firm / Agency
 Witness Tree Surveying
 Address
 P.O. Box G
 Pilot Rock, Or. 97868
 Party Chief
 Stephen K, Haddock

REGISTERED
 PROFESSIONAL
 LAND SURVEYOR

Stephen K. Haddock

OREGON
 JULY 9, 2001
 STEPHEN K. HADDOCK
 56295LS

RENEWAL DATE 6-30-07