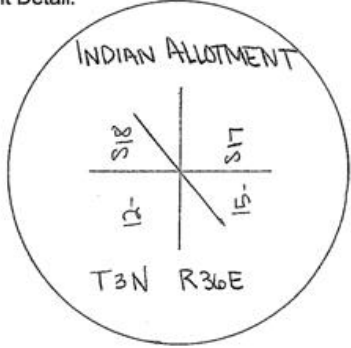
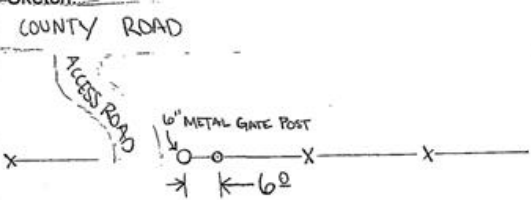
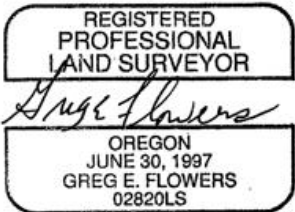


ORIG **N PUBLIC LAND CORNER REPORT / RESTORATION REPC**  
 Umatilla County Surveyor's Office

<b>SECTION</b> 17 and 18	<b>TOWNSHIP</b> 3N	<b>RANGE</b> 36E
<b>COUNTY:</b> Umatilla		<b>DATE</b> 6/20/08
<b>CORNER DESIGNATION: M-5</b>  South 1/16 corner common to sections 17 and 18		<b>(Please check one)</b>
		<input checked="" type="checkbox"/> Condition Report Only
		<input type="checkbox"/> Not Found
		<input type="checkbox"/> Renewed
		<input type="checkbox"/> Unrecorded
		<input type="checkbox"/> Surveyed In
		<input type="checkbox"/> Referenced Out
Previous Renewals / Surveys, etc.  U.S. Indian Services Surveyor C.E. Redfield, set an Iron Post in 1919		
<b>Monument(s) &amp; Accessories Found: (Condition &amp; Source)</b>  Found a 2" galvanized Iron Pipe with a 2 1/2" Brass Cap in good condition, protruding 12" from the ground in an East-West fence line, 6 feet East of a 6" metal gate post.		
<b>Monument Detail:</b>  	<b>Sketch:</b>  	
<b>Monument Set (Procedures and Description):</b>		
<b>New Accessories:</b>		
<b>Location &amp; Comments:</b>  Corner is located in an open flat on an East-West fence line, 6 feet East of a 6" metal gate post in a road entering from the County Road from the North. The corner is 230 feet South of the County Road		<b>Compass Declination:</b>
<b>Firm / Agency</b> USKH Address: 5 N. Colville St., Walla Walla, Wa 99632		<b>SURVEYOR'S SEAL</b>    RENEWS 12/31/09 6/30/08
<b>Party Chief</b> Greg E. Flowers		
<b>Notes</b>		
<b>Witness</b> Damon Locke		

08-112-C