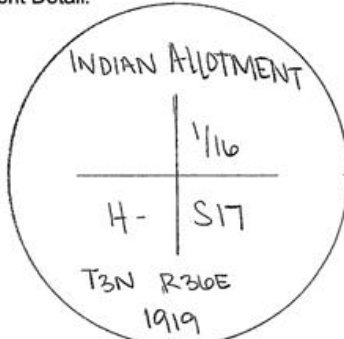
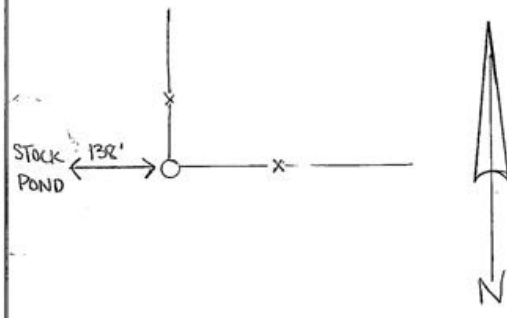
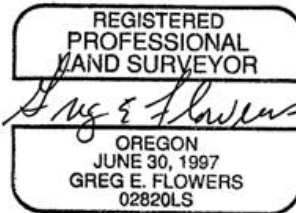


OREGON PUBLIC LAND CORNER REPORT / RESTORATION REPORT
 Umatilla County Surveyor's Office

SECTION 17	TOWNSHIP 3N	RANGE 36E
COUNTY: Umatilla		DATE 6/20/08
CORNER DESIGNATION: M-6 Southwest 1/16 of Section 17		(Please check one) <input checked="" type="checkbox"/> Condition Report Only <input type="checkbox"/> Not Found <input type="checkbox"/> Renewed <input type="checkbox"/> Unrecorded <input type="checkbox"/> Surveyed In <input type="checkbox"/> Referenced Out
Previous Renewals / Surveys, etc. U.S. Indian Services Surveyor C.E. Redfield set an iron post in 1919.		
Monument(s) & Accessories Found: (Condition & Source) Found a 2" galvanized iron pipe with a 2 1/2" brass cap protruding 12" at a fence corner with fences running North and East. The corner is in good condition.		
Monument Detail: 	Sketch: 	
Monument Set (Procedures and Description):		
New Accessories: Rebuilt stone mound		
Location & Comments: The corner is located on the east side of a shallow draw 138' East of a stock pond in a fence corner with fences running North and East.		Compass Declination:
Firm / Agency USKH Inc. Address: 5 N. Colville St. Walla Walla, WA 99362 Party Chief Greg E. Flowers		SURVEYOR'S SEAL 
Notes		
Witness Damon Locke		

RENEWS 12/31/09

6/30/08