

USDA-FOREST SERVICE

Index

File No. X-21

CORNER RECORD (SEARCH)

(Ref. FSM 7151.4)

Tract or

Survey No. _____

Cor.

No. _____

T 3N R. 36E

R.D. Walla Walla

County Umatilla


Merid. Willamette

N.F. Umatilla

State Oregon

CORNER DIAGRAM Sec. 36

DESCRIBE CORNER MONUMENT FOUND

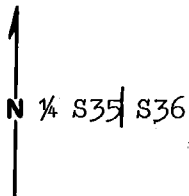

DESCRIBE BEARING TREES OR OTHER OFFICIAL ACCESSORIES FOUND

Orig. 16" now down 18" Tamarack axe & fragmentary scribe marks on 2'x6" slab from BT lying at corner position N5E-11.2 ft..

PHOTO IDENTIFICATION DATA

Photo No. 1280-55

Filed At. Umatilla N.F.

Object Ident. two I.P.'s

Ident. By L. Bishop
Signature

DESCRIBE CORNER LOCATION RELATIVE TO NEAR-BY FEATURES, ALSO HOW TO REACH CORNER

Corner is South 1/4 mile from where Boise Cascade Co. road hits ridge top.

PLANE COORDINATE POSITION DATA

State _____ Zone _____

X _____

Y _____

Estab. By _____
Agency

Signature

Title

Division

Headquarters

Date

Lung D. Bishop

Land Surveyor

6/83

7100-52-(3,68)

CORNER RECORD (PERPETUATION)

MONUMENT : DESCRIBE NEW MONUMENT SET, OR WORK DONE TO PRESERVE EXISTING MONUMENT

Set 2½"x30" Aluminum pipe with a 2½" Aluminum cap.

ACCESSORIES : DESCRIBE NEW BT'S WITNESS OBJECTS ETC. ESTABLISHED, OR WORK DONE TO PRESERVE EXISTING EVIDENCE

14" Wh.Fir West-13.3 ft. scribed ¼S35BT and with a 1" Brass disk stamped PLS 896.

18" Wh.Fir N75E-5.4 ft. scribed ¼S36BT and with a 1" Brass disk stamped PLS 896.

Work Done By Larry D. Bishop Title Surveyor Date 6/83 State Registration No. 896
or Agency

Certified Cor. Record Prepared ? Yes No Filed At: _____ Date _____

REMARKS

Set guard post South with signs 54-2 and 54-4.
Nailed 54-4 and BT signs to BT's and painted band and blazes red.

Index File No. X-21

CORNER RECORD (SEARCH)

(Ref. FSM 7151.4)

Tract or

Cor.

T 3N R. 36E

R.D. WALLA WALLA County UMATILLA


Survey No. _____

No. _____

Merid. Will.

N.F. UMATILLA State OREGON

CORNER DIAGRAM

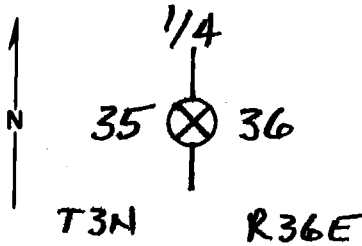

DESCRIBE CORNER MONUMENT FOUND

NONE

DESCRIBE BEARING TREES OR OTHER OFFICIAL ACCESSORIES FOUND

ORIG. 16" TAM. IS DOWN & DECAYED. I FIND AXE MARKS & FRAGMENTARY SCRIBING ON AN UNHEALED FACE. BEARS N5°E, 113 FT. ORIG. 12" TAM. IS GONE.

PHOTO IDENTIFICATION DATA

Photo No. _____
 Filed At. _____
 Object Ident. _____
 Ident. By _____
 Signature _____

DESCRIBE CORNER LOCATION RELATIVE TO NEAR-BY FEATURES, ALSO HOW TO REACH CORNER

CORNER IS 500' NORTH OF JEEP ROAD ON STARVE - TO - DEATH RIDGE. PLACED "K" TAG 75' NORTH OF JEEP RD, ON A SMALL FIR.

PLANE COORDINATE POSITION DATA

State _____ Zone _____
 X _____
 Y _____
 Estab. By _____
 Agency _____

Signature Dennis L. Gaylord Title _____ Division _____ Headquarters _____ Date 6-25-82

CORNER RECORD (PERPETUATION)

MONUMENT : DESCRIBE NEW MONUMENT SET, OR WORK DONE TO PRESERVE EXISTING MONUMENT

ACCESSORIES : DESCRIBE NEW BT'S WITNESS OBJECTS ETC. ESTABLISHED, OR WORK DONE TO PRESERVE EXISTING EVIDENCE

Work Done By _____ Title _____ Date _____ State Registration No. _____
or Agency _____

Certified Cor. Record Prepared ? Yes No Filed At: _____ Date _____

REMARKS

Index File No. T. R. M. Tract or Surv. No. Cor.