

Index

File No. C-25

CORNER RECORD (SEARCH)

(Ref. FSM 7151.4)

Tract or Survey No. _____ Cor. No. _____


T 3N R. 37E

R.D. Walla Walla County Umatilla

Merid. Willamette

N.F. Umatilla State Oregon

CORNER DIAGRAM

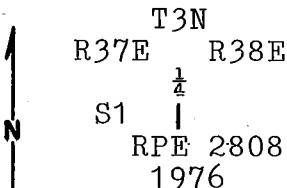

DESCRIBE CORNER MONUMENT FOUND

Found 2 1/2" brass cap. on 2 1/2" galv. iron pipe projecting 4" out of the ground.

DESCRIBE BEARING TREES OR OTHER OFFICIAL ACCESSORIES FOUND

A 20" white fir bears S 75°W, 61.0' with healed double blaze. (RPE2808 BT).
A 40" very rotten white fir bears S 60°W, 8.6' with axe marks visible. (Orig. BT.).

PHOTO IDENTIFICATION DATA

Photo No. _____
Filed At. _____
Object Ident. _____
Ident. By _____
Signature

DESCRIBE CORNER LOCATION RELATIVE TO NEAR-BY FEATURES, ALSO HOW TO REACH CORNER

Corner is located about 600' north of a road running Southwesterly. There is a wood post on road with location poster.

PLANE COORDINATE POSITION DATA

State _____ Zone _____
X _____
Y _____
Estab. By _____
Agency

Signature
Wells R. Wells

Title PLS Division _____ Headquarters Pendleton, OR Date 9/13/91 FS-7100-52 (3/88)

CORNER RECORD (PERPETUATION)

MONUMENT: DESCRIBE NEW MONUMENT SET, OR WORK DONE TO PRESERVE EXISTING MONUMENT

Maintained existing monument by mounding with earth. Set steel fence post south of corner and attached sign 54-2 and 54-9.

ACCESSORIES : DESCRIBE NEW BT'S WITNESS OBJECTS ETC. ESTABLISHED, OR WORK DONE TO PRESERVE EXISTING EVIDENCE

Marked 3 new bearing trees:

A 13" englemann spruce bears S 38°W, 30.7' scribed 1/4 S1 BT.

A 11" englemann spruce bears N 45°W, 26.8' scribed 1/4 S1 BT.

A 11" white fir bears N 24½°W, 65.9' scribed 1/4 S1 BT.

New bearing trees have a brass washer stamped PLS 1106 nailed to face of blaze. Attached sign 54-3 and 54-9 and painted face of blaze and a 6" red band around all bearing trees.

Work Done By W.R. Wells Title PLS Date 9/13/91 State Registration No. 1106
or Agency

Certified Cor. Record Prepared ? Yes No Filed At: Umatilla Co. Surveyor Off. Date 12/31

REMARKS

Index File No. C-25 T. 3N R. 37E M. Will. Tract or Surv. No. Cor.

Index File No. C 25

CORNER RECORD (SEARCH)

(Ref. FSM 7151.4)

Tract or Survey No. _____

Cor. No. C 25


T 3 N R. 37 E

R.D. Pendleton County Umatilla

Merid. Willamette

N.F. Umatilla State Oregon

CORNER DIAGRAM

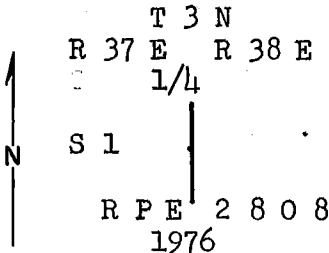

DESCRIBE CORNER MONUMENT FOUND

NONE

DESCRIBE BEARING TREES OR OTHER OFFICIAL ACCESSORIES FOUND

A fir stump 40" diam. with log lying alongside with full scribing visible (1/4 S BT) inside 6" overgrowth bears S 60° W., 8.58 ft. (13 lks) with Forest Service location tag attached dated 6-1-64

No trace of sec. 6 BT..

PHOTO IDENTIFICATION DATA

Photo No. _____
 Filed At. _____
 Object Ident. _____
 Ident. By _____
 Signature _____

DESCRIBE CORNER LOCATION RELATIVE TO NEAR-BY FEATURES, ALSO HOW TO REACH CORNER

Westerly from west edge of Tollgate 3.5 miles to road south between metal snow fence-Thence southerly 1.2 miles to creek crossing and road forks-Thence on left fork 0.9 miles to Reforestation Project P36 sign-Thence northeasterly 0.2 miles to top of ridge and location tag. Corner is north 830 feet.

PLANE COORDINATE POSITION DATA

State _____ Zone _____
 X _____
 Y _____
 Estab. By _____
 Agency _____

Title RPE 2808 Division _____ Headquarters _____ Date 7/27/76 7100-52 (3/68)

Signature James D. Haulley

CORNER RECORD (PERPETUATION)

MONUMENT: DESCRIBE NEW MONUMENT SET, OR WORK DONE TO PRESERVE EXISTING MONUMENT

Set a 2 $\frac{1}{2}$ " brass cap on a 2" iron pipe 31" long 6" above the ground with a 6' steel fence post 3' north with signs 54-4 and 54-2 attached.

ACCESSORIES : DESCRIBE NEW BT's WITNESS OBJECTS ETC. ESTABLISHED, OR WORK DONE TO PRESERVE EXISTING EVIDENCE

A fir 12" diam. bears S 73° W., 61.5 ft. dist. marked 1/4 S 1 BT with a sign 54-3 attached 6" below a band of red paint and a brass washer marked RPE 2808 nailed flush with BT blaze.

Work Done By. James D. Hanley Title Engineer Date 7/27/76 State Registration No. ORPE 2808
or Agency

Certified Cor. Record Prepared ? Yes XXX Filed At: Rehleton, Oregon Date 8/ /76

REMARKS

Corner is on top of ridge.