

USDA-FOREST SERVICE

Index
File No. WB 928

CORNER RECORD (SEARCH)
(Ref. FSM 7151.4)

Tract or
Survey No. _____ Cor.
No. _____


T 3N R. 37E

R.D. WALLA WALLA County UMATILLA

Merid. WILLAMETTE

N.F. UMATILLA State OREGON

CORNER DIAGRAM

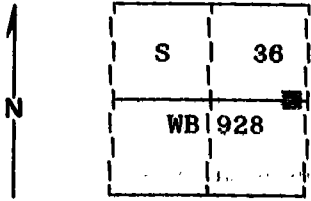

DESCRIBE CORNER MONUMENT FOUND

Corner not previously established.

DESCRIBE BEARING TREES OR OTHER OFFICIAL ACCESSORIES FOUND

No accessories previously established.

PHOTO IDENTIFICATION DATA

Photo No. _____
Filed At. _____
Object Ident. _____
Ident. By _____
Signature

DESCRIBE CORNER LOCATION RELATIVE TO NEAR-BY FEATURES, ALSO HOW TO REACH CORNER

Corner falls on gentle West slope approximately
100 feet West of the 3150-035 road.

PLANE COORDINATE POSITION DATA

State _____ Zone _____
X _____
Y _____
Estab. By _____

Agency Signature

Title _____ Division _____ Headquarters _____ Date _____

CORNER RECORD (PERPETUATION)

MONUMENT: DESCRIBE NEW MONUMENT SET, OR WORK DONE TO PRESERVE EXISTING MONUMENT

Set a 2½"x30" aluminum pipe with aluminum cap marked as shown:
Pipe is set 24 inches in the ground.

WB 928

Raised a mound of stone around monument, 3 ft. base to top of cap

1991
OPLS 644

ACCESSORIES : DESCRIBE NEW BT'S WITNESS OBJECTS ETC. ESTABLISHED, OR WORK DONE TO PRESERVE EXISTING EVIDENCE

New BTs:

A 21 inch diam. Ponderosa Pine bears S81°E, 32.9 feet marked WB 928 BT
A 24 inch diam. Douglas Fir bears N60°W, 4.07 feet marked WB 928 BT

Attached Bearing Tree and Land Survey Monument signs to the BTs
Set a steel fencepost approximately 5 feet Northeasterly with
Land Survey Monument and Wilderness Boundary signs attached.

10

Work Done By D.I. Griffith Title Surveyor Date 10-10-92 State Registration No. OPLS 644
or Agency
Certified Cor. Record Prepared? Yes No Filed At: Umatilla Co. Surveyor Off. Date 10-92

11

REMARKS

Witnesses: Jeff Petersen and Jim Bennett

12

Index File No. T. R. M. Tract or Surv. No. Cor. 13