

USDA-FOREST SERVICE

Index

File No. A 13

CORNER RECORD (SEARCH)

(Ref. FSM 7151.4)

Tract or

Survey No. _____

Cor.

No. _____

T 31N R. 38E

R.D. Walla Walla


County Umatilla

Merid. Will

N.F. Umatilla

State Oregon

CORNER DIAGRAM

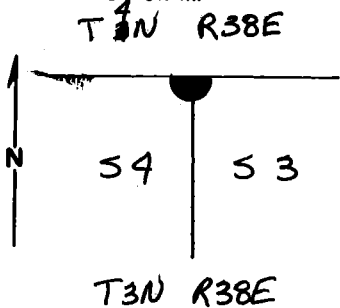

DESCRIBE CORNER MONUMENT FOUND

Found iron post, 2" dia, with brass cap 6" above ground and firmly in place.

DESCRIBE BEARING TREES OR OTHER OFFICIAL ACCESSORIES FOUND

(No notes for this corner)

Found BT for section 3, a 24" dia. fir and obliterated BT.

Put up BT and atth signs.

PHOTO IDENTIFICATION DATA

Photo No. _____

Filed At. _____

Object Ident. _____

Ident. By _____

Signature

PLANE COORDINATE POSITION DATA

State _____ Zone _____

X _____

Y _____

Estab. By _____

Agency

Signature

Sue Newsletter

Title

Civil Eng Tech

Division

Headquarters

SO

Date

6/25/84

7100-52-(3,68)

CORNER RECORD (PERPETUATION)

MONUMENT : DESCRIBE NEW MONUMENT SET, OR WORK DONE TO PRESERVE EXISTING MONUMENT

ACCESSORIES : DESCRIBE NEW BT'S WITNESS OBJECTS ETC. ESTABLISHED, OR WORK DONE TO PRESERVE EXISTING EVIDENCE

Work Done By _____ Title _____ Date _____ State Registration No. or Agency _____
Certified Cor. Record Prepared ? Yes No Filed At: _____ Date _____

REMARKS

Index File No. T. R. M. Tract or Surv. No. Cor.