

Form 874-9—Revised May, 1918

U. S. Department of Agriculture

FOREST SERVICE

Umatilla NATIONAL FOREST

CORNERS OF THE PUBLIC SURVEY

T. 3N R. 38E W. Mer.

Section Corner common to Sections 4, 5, 8, and 9

Corner consists of a not found definitely (not) in place State condition

Dimensions above ground inches.

Sketch grooves, letters, figures, or notches, on proper face or edge.

CARDINAL POSITION

DIAGONAL POSITION

Grid for cardinal position with columns N, W, S, E

Grid for diagonal position with columns NW, SW, SE, NE

Mound of Rock is located at approx. Cor.

no Pits are located

Sketch markings of Bearing Trees (or Rocks) in proper box and fill blanks below, giving bearings from Corner to Trees and Distances in Links.

Sketch boxes for bearing trees with handwritten 'grown over' and empty boxes below

Species Fir Diameter 13" Bearing S20°E Distance 35'

Do you believe this to be a genuine Land Office Corner? yes

If not, why? The three bearing trees need chopping out, but are unquestionably B. T.S.


Bernard Lee (Signature)

Sept 10, 1931 (Date)

J. R. E. (Title)

T. 31N R. 38E W Mer.

(Make sketch of topography near Corner)

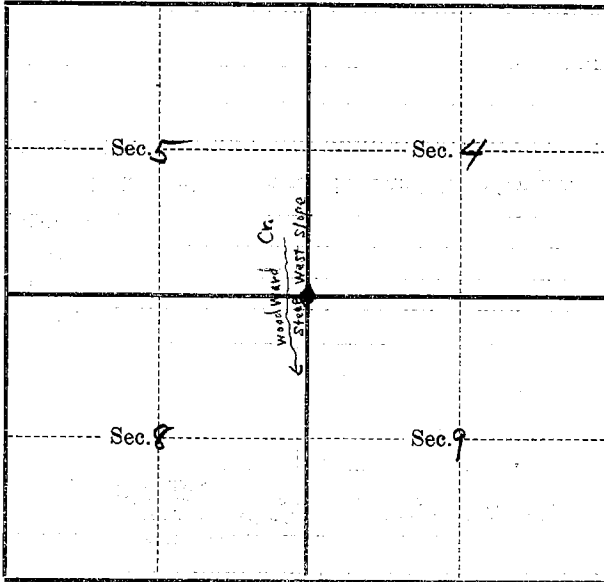

Metal Location Poster is on a Basin tree
tree 13 inches diameter, on the North
side of the tree
from which this Corner bears N20°W.
about 1/2 chains distant.

Give any further facts which will aid in finding this
Corner again.

USDA-FOREST SERVICE

Index File No. E-9

CORNER RECORD (SEARCH)

(Ref. FSM 7151.4)

Tract or Survey No. _____


Cor. No. _____

T 3N R. 38E R.D. WALLA WALLA County UMATILLA

Merid. WILLAMETTE N.F. UMATILLA State OREGON

CORNER DIAGRAM

T3N R38E

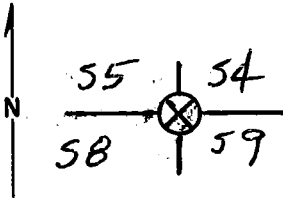

DESCRIBE CORNER MONUMENT FOUND

NONE - PROBABLY ROLLED DOWN STEEP SLOPE,

DESCRIBE BEARING TREES OR OTHER OFFICIAL ACCESSORIES FOUND

ORIG. 18" FIR IS DOWN ON FACE. ROOT HOLE BEARS N89°E, 55 LINKS. ORIG. 8" FIR IS NOW 18" WITH DOUBLE HEALED BLAZES. BEARS S70°E, 72 LINKS. ORIG. 14" FIR IS NOW 24" WITH HEALED BLAZE. BEARS S10°W, 69 LINKS. ORIG. 18" FIR IS NOW 32" WITH HEALED BLAZE. IS LEANING WEST.

DESCRIBE CORNER LOCATION RELATIVE TO NEAR-BY FEATURES, ALSO HOW TO REACH CORNER BEARS N18°W (RECORD N4 1/2°W), 125 LINKS.

AT THE 1901 CORNER (SUPERCEDED) I FOUND: (NORTH, 296.34 FEET FROM ABOVE CORNER) ORIG. 18" FIR IS LIVE WITH HEALED BLAZE. BEARS N33 1/2°E, 127 LINKS. ORIG. 16" FIR IS A DECAYED ROOT CROWN. BEARS S31°E, 70 LINKS. (CONT. ON BACK)

PHOTO IDENTIFICATION DATA

Photo No. _____
 Filed At. _____
 Object Ident. _____
 Ident. By _____
 Signature _____

PLANE COORDINATE POSITION DATA

State _____ Zone _____
 X _____
 Y _____
 Estab. By _____
 Agency _____

Signature Dennis L. Paylord Title _____ Division PLS 1636 Headquarters _____ Date SEPT 19, 1997 FS-7100-52 (3/68)

CORNER RECORD (PERPETUATION)

MONUMENT: DESCRIBE NEW MONUMENT SET, OR WORK DONE TO PRESERVE EXISTING MONUMENT

NONE

ACCESSORIES : DESCRIBE NEW BT'S WITNESS OBJECTS ETC. ESTABLISHED, OR WORK DONE TO PRESERVE EXISTING EVIDENCE

I PUT BT SIGNS ON THE 4 BT'S' CORNER IS ABOUT 75 FEET NORTH OF TOP OF SPUR RIDGE,

1901 SUPERCEDED CORNER, CONTINUED:

ORIG. 10" FIR IS A ~~LEADING~~ SNAG WITH AN OLD K-TAG (RUSTY) & DOUBLE HEALED BLAZES. BEARS S1°W, 6 BLINKS, ORIG. 30" FIR IS LIVE WITH LARGE HEALED BLAZE. BEARS N26 1/2° W, 146 LKS.

Work Done By _____ Title _____ Date _____ State Registration No. or Agency _____

Certified Cor. Record Prepared? Yes No Filed At: _____ Date _____

THIS IS ALSO THE 30" BT. ^{REMARKS} FOR THE 1899 SUPERCEDED CORNER & HAS ANOTHER HEALED BLAZE FACING THE 1899 CORNER POINT. FROM THE 1901 CORNER, THE 1899 CORNER BEARS N27 1/2° W, 160 LINKS. I FOUND: ORIG. 8" FIR IS LIVE WITH DOUBLE HEALED BLAZES. BEARS N10 1/2° E, 59 LINKS, ORIG. 30" FIR DESCRIBED ABOVE BEARS S45° E, 6 LINKS, ORIG. 6" FIR IS A LEANING SNAG W/ DOUBLE HEALED BLAZE, BR^{563°W} 12/16/97 ¹³ LKS

Index File No. T. R. M. Tract or Surv. No. Cor. 13

E-9 T3N R38E ORIG. 6" FIR TO NW IS GONE,