

Index File No. G-13

CORNER RECORD (SEARCH)

(Ref. FSM 7151.4)


Tract or Survey No. _____ Cor. No. _____

T 3N R. 38E R.D. WALLA WALLA County UNION

Merid. WILLAMETTE N.F. UMATILLA State OREGON

CORNER DIAGRAM

T3N R38E

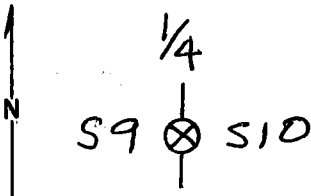

DESCRIBE CORNER MONUMENT FOUND

NONE

DESCRIBE BEARING TREES OR OTHER OFFICIAL ACCESSORIES FOUND

ORIG. 6" FIR IS NOW A 20" LIVE WHITE FIR WITH DOUBLE HEALED BLAZES. BEARS N75°W, 28 LKS. (18.5ft)

ORIG. 5" FIR IS A 12" LIVE LODGEPOLE PINE WITH DOUBLE HEALED BLAZES. I OPEN UPPER BLAZE & FIND FULL SCRIBES. BEARS N24°E, 23 LKS. (16.3ft)

DESCRIBE CORNER LOCATION RELATIVE TO NEAR-BY FEATURES, ALSO HOW TO REACH CORNER

I PLACED BT SIGNS ON BOTH TREES. CORNER IS NORTHWEST OF SUMMER HOMES,

PHOTO IDENTIFICATION DATA

Photo No. _____
 Filed At. _____
 Object Ident. _____
 Ident. By _____
 Signature _____

PLANE COORDINATE POSITION DATA

State _____ Zone _____
 X _____
 Y _____
 Estab. By _____
 Agency _____

Signature _____ Title _____ Division _____ Headquarters _____ Date _____

Dennis A. Gaylord PLS 1636 S.O. 5/11/94

CORNER RECORD (PERPETUATION)

MONUMENT: DESCRIBE NEW MONUMENT SET, OR WORK DONE TO PRESERVE EXISTING MONUMENT.

ACCESSORIES : DESCRIBE NEW BT's WITNESS OBJECTS ETC. ESTABLISHED, OR WORK DONE TO PRESERVE EXISTING EVIDENCE

Work Done By _____ Title _____ Date _____ State Registration No. _____
or Agency _____
Certified Cor. Record Prepared ? Yes No Filed At: _____ Date _____

REMARKS

Index File No. T. R. M. Tract or Surv. No. Cor.