

USDA-FOREST SERVICE

Index
File No. J-3
T 3N R. 38E
Merid. WILLAMETTE


CORNER RECORD (SEARCH)

(Ref. FSM 7151.4)

Tract or
Survey No. _____
R.D. WALLA WALLA County UMATILLA
N.F. UMATILLA State OREGON

Cor.
No. _____

CORNER DIAGRAM

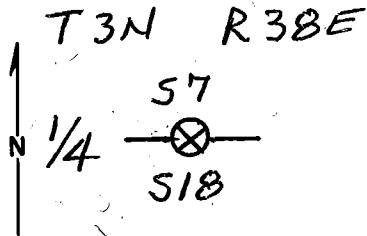

DESCRIBE CORNER MONUMENT FOUND

STONE OF RECORD SIZE WITH POSSIBLE CHISEL MARKS, I PUT A RED FLAG AROUND STONE, WHICH IS LYING LOOSE ON STEEP SOUTH SLOPE.

DESCRIBE BEARING TREES OR OTHER OFFICIAL ACCESSORIES FOUND

NONE - SUPERCEDED CORNER SET IN 1899 BEARS NORTH, 273 FEET, I FOUND AS FOLLOWS: ORIG. 24" FIR IS A 36" DOUG-FIR WITH HEALED BLAZE. BEARS N54°30'W, 195.36 FEET. ORIG. 18" FIR IS DOWN

PHOTO IDENTIFICATION DATA

Photo No. _____
Filed At. _____
Object Ident. _____
Ident. By _____
Signature _____

DESCRIBE CORNER LOCATION RELATIVE TO NEAR-BY FEATURES, ALSO HOW TO REACH CORNER

& DECAYED. I OPEN & FIND REVERSE SCRIBES "BT" AND OTHER FRAGMENTARY SCRIBES ON UPPER BLAZE WHICH WERE CHOPPED OUT IN 1903. PARTIAL STUMP & ROOT CROWN BEARS S49°45'W, 160.38 FT.

PLANE COORDINATE POSITION DATA

State _____ Zone _____
X _____
Y _____
Estab. By _____
Agency _____

Signature

Title

Division

Headquarters

Date

FS-7100-52 (3/68)

Dennis A. Gaylord PLS 1636 SEPT 17, 1997

CORNER RECORD (PERPETUATION)

MONUMENT: DESCRIBE NEW MONUMENT SET, OR WORK DONE TO PRESERVE EXISTING MONUMENT

ACCESSORIES : DESCRIBE NEW BT'S WITNESS OBJECTS ETC. ESTABLISHED, OR WORK DONE TO PRESERVE EXISTING EVIDENCE

I PUT BT SIGN ON LIVE FIR AND ALSO ON DOWN TREE WITH SCRIBING VISIBLE.

Work Done By _____ Title _____ Date _____ State Registration No. or Agency _____

Certified Cor. Record Prepared? Yes No Filed At: _____ Date _____

REMARKS

I DID NOT GPS THIS CORNER AS RECEIVER BATTERIES WERE DEAD.

Index File No. J-3 T. T3N R. R3BE M. WILL Tract or Surv. No. Cor. 13